


54247

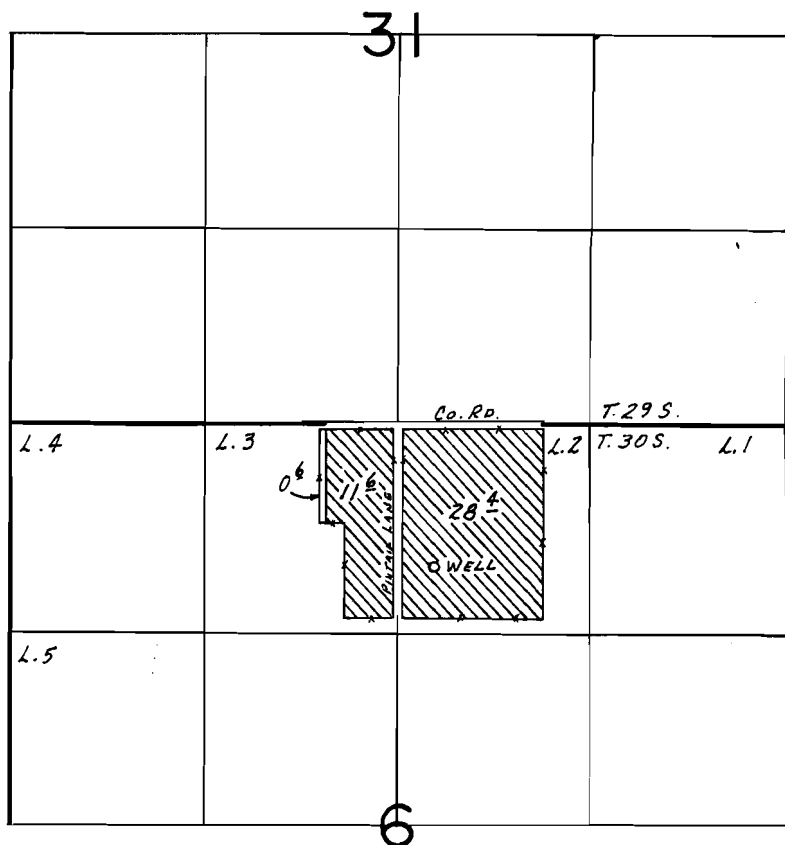

SCALE: 1"=1320'

# FINAL PROOF SURVEY

## UNDER

Application No. G-9267. Permit No. G-8707.....  
IN NAME OF

.....RUNNIN' W. RANCH.....

Surveyed Oct. 14.... 19.85, by B.W. BISHOP.....

RWB