


G-9204
54248

T. 27S., R. 13E., W.M.

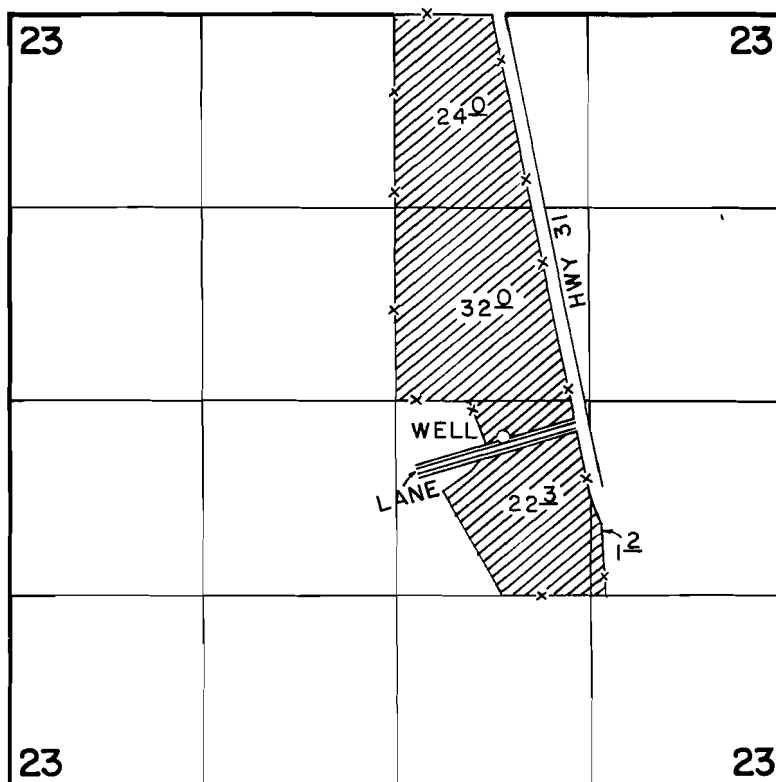

WELL LOC.: 2900'S. & 70'E. FROM THE N. 1/4 CORNER SEC. 23

SCALE: 1" = 1320'

FINAL PROOF SURVEY

UNDER

Application No. G-10166. Permit No. G-9204....
IN NAME OF

PERCY P. CROFOOT.....

Surveyed SEPT. 12. 1985., by T. WARREN.....