


G-9465

54250

T. 25S., R. 19E., W.M.

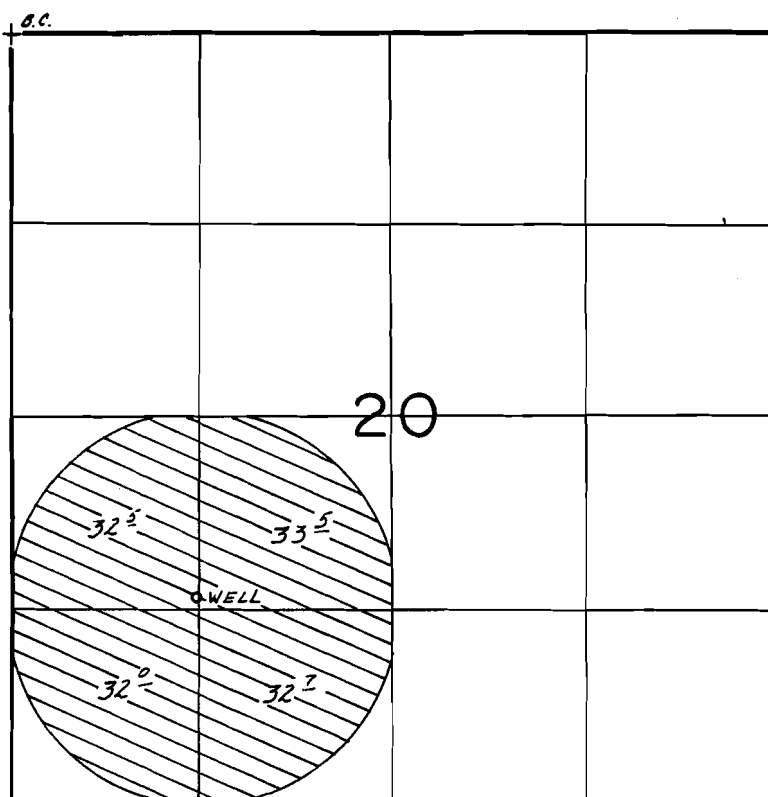

WELL LOC.: 3880 S. & 1290 E. FROM NW COR. SEC. 20.

SCALE: 1" = 1320'

FINAL PROOF SURVEY

UNDER

Application No. G-10373 Permit No. G-9465....
IN NAME OF

LAWRENCE H. & DELLA M. MATTINGLY

Surveyed Sept. 18... 19.85, by B.W. BISHOP.....