


T.27S.,R.15E.,W.M.

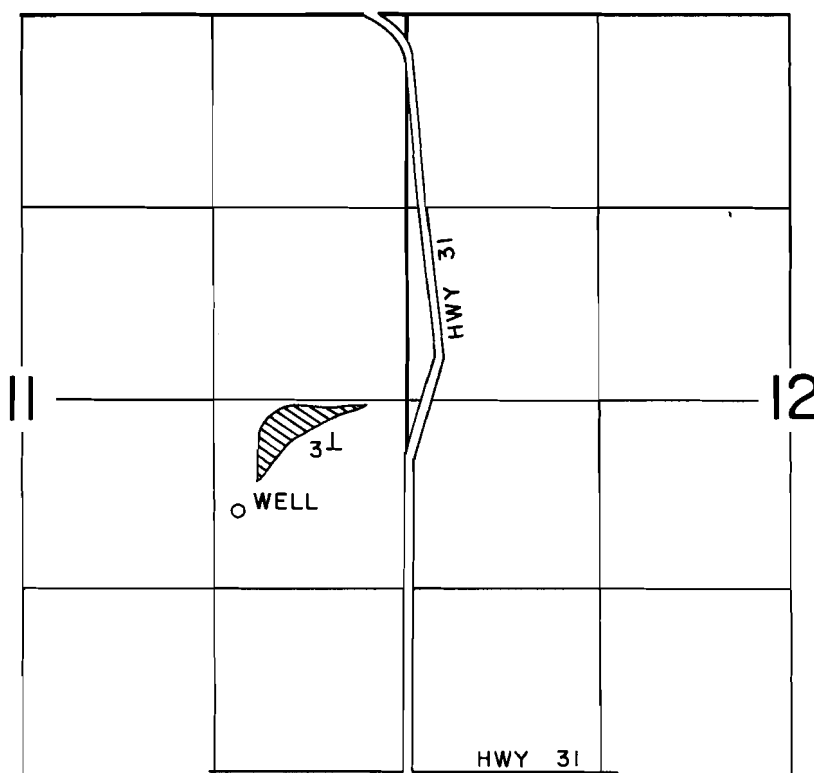

WELL LOC: 750' S. & 1150' W. FROM THE E. 1/4 CORNER SEC. 11

SCALE: 1" = 1320'

FINAL PROOF SURVEY
UNDER

Application No. G-11197 Permit No. G-10331...
IN NAME OF

.....GEORGE SCOTT.....

Surveyed SEPT. 14, 1985, by J. WARREN.....