


# T.16S., R.8W., W.M.

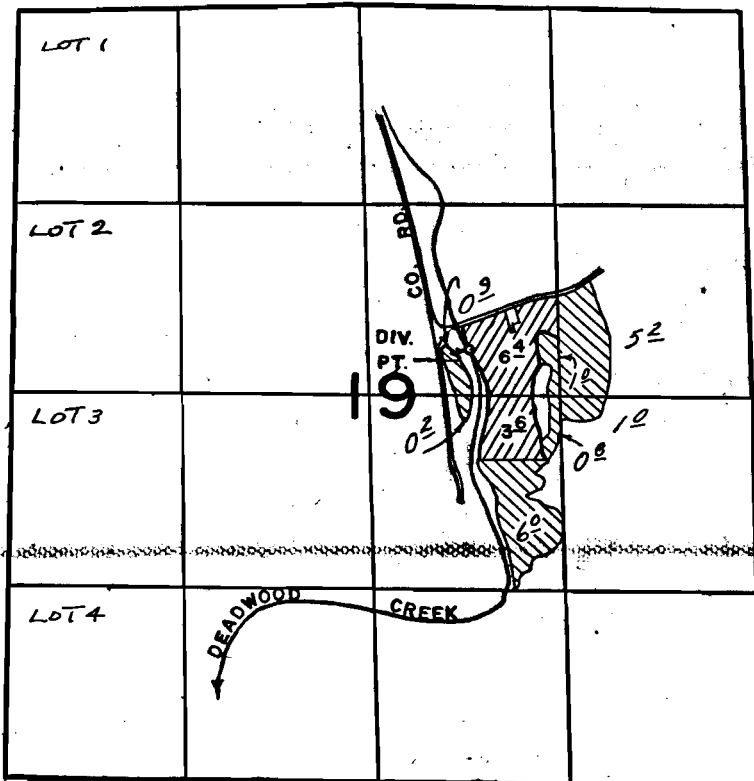


● FD. REF. COR.

DIV. PT. LOC.: 2960' N. & 3130'E. FROM SW CORNER OF SECTION 19.

SCALE: 1"=1320'

## FINAL PROOF SURVEY UNDER

57842

43805 

Application No. 50395..... Permit No. 36767...   
IN NAME OF

.....CAROLINE ESTES.....

Surveyed AUG.25.. 1977., by B.R.SUND.....

MAY 25 1979

R.G. MUCKEN

JULY 30 1986

B.W. BISHOP (57842)

ADDITIONS 12/31/86  
DBQ-3JJ-179 86