


T. 19S., R. 2W., W.M.

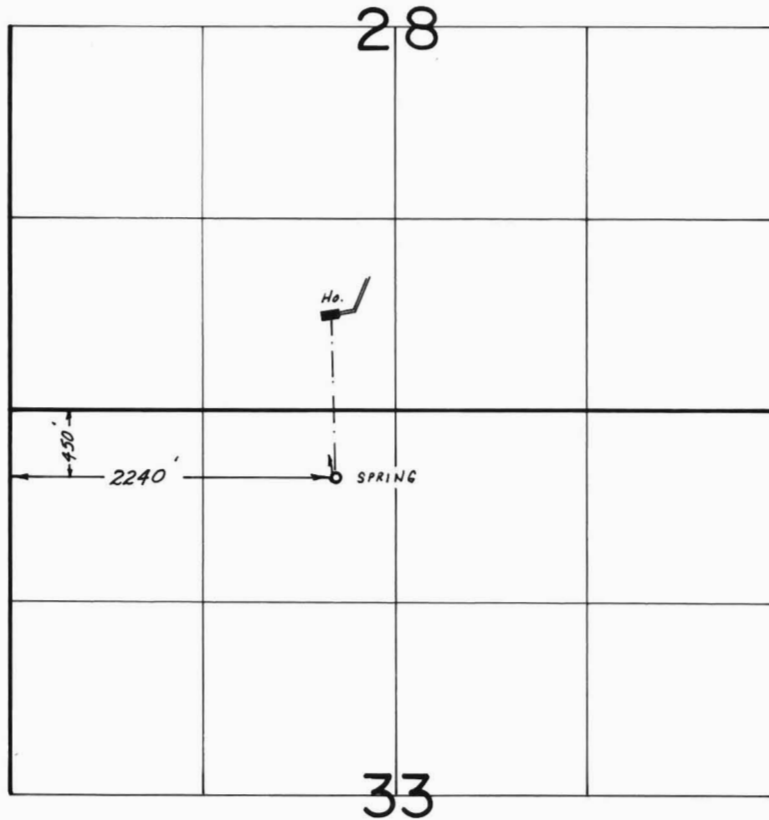

SCALE: 1" = 1320'

FINAL PROOF SURVEY UNDER

Application No. 60580.. Permit No. 45198.....
IN NAME OF

...CHESTER R. &/OR HELEN L. WOLF

Surveyed Aug. 27.. 19.84, by P.R. PAGTER.....