

64622

NE.1/4 SW.1/4 Sec 20 T.17S. R.5W.W.M.

RECEIVED

17 05 20 3 1

64622

LANE COUNTY


1"=100'

FEB 17 1983
WATER RESOURCES DEPT.
SALEM, OREGON



028-16

FERN RIDGE RESEVOIR

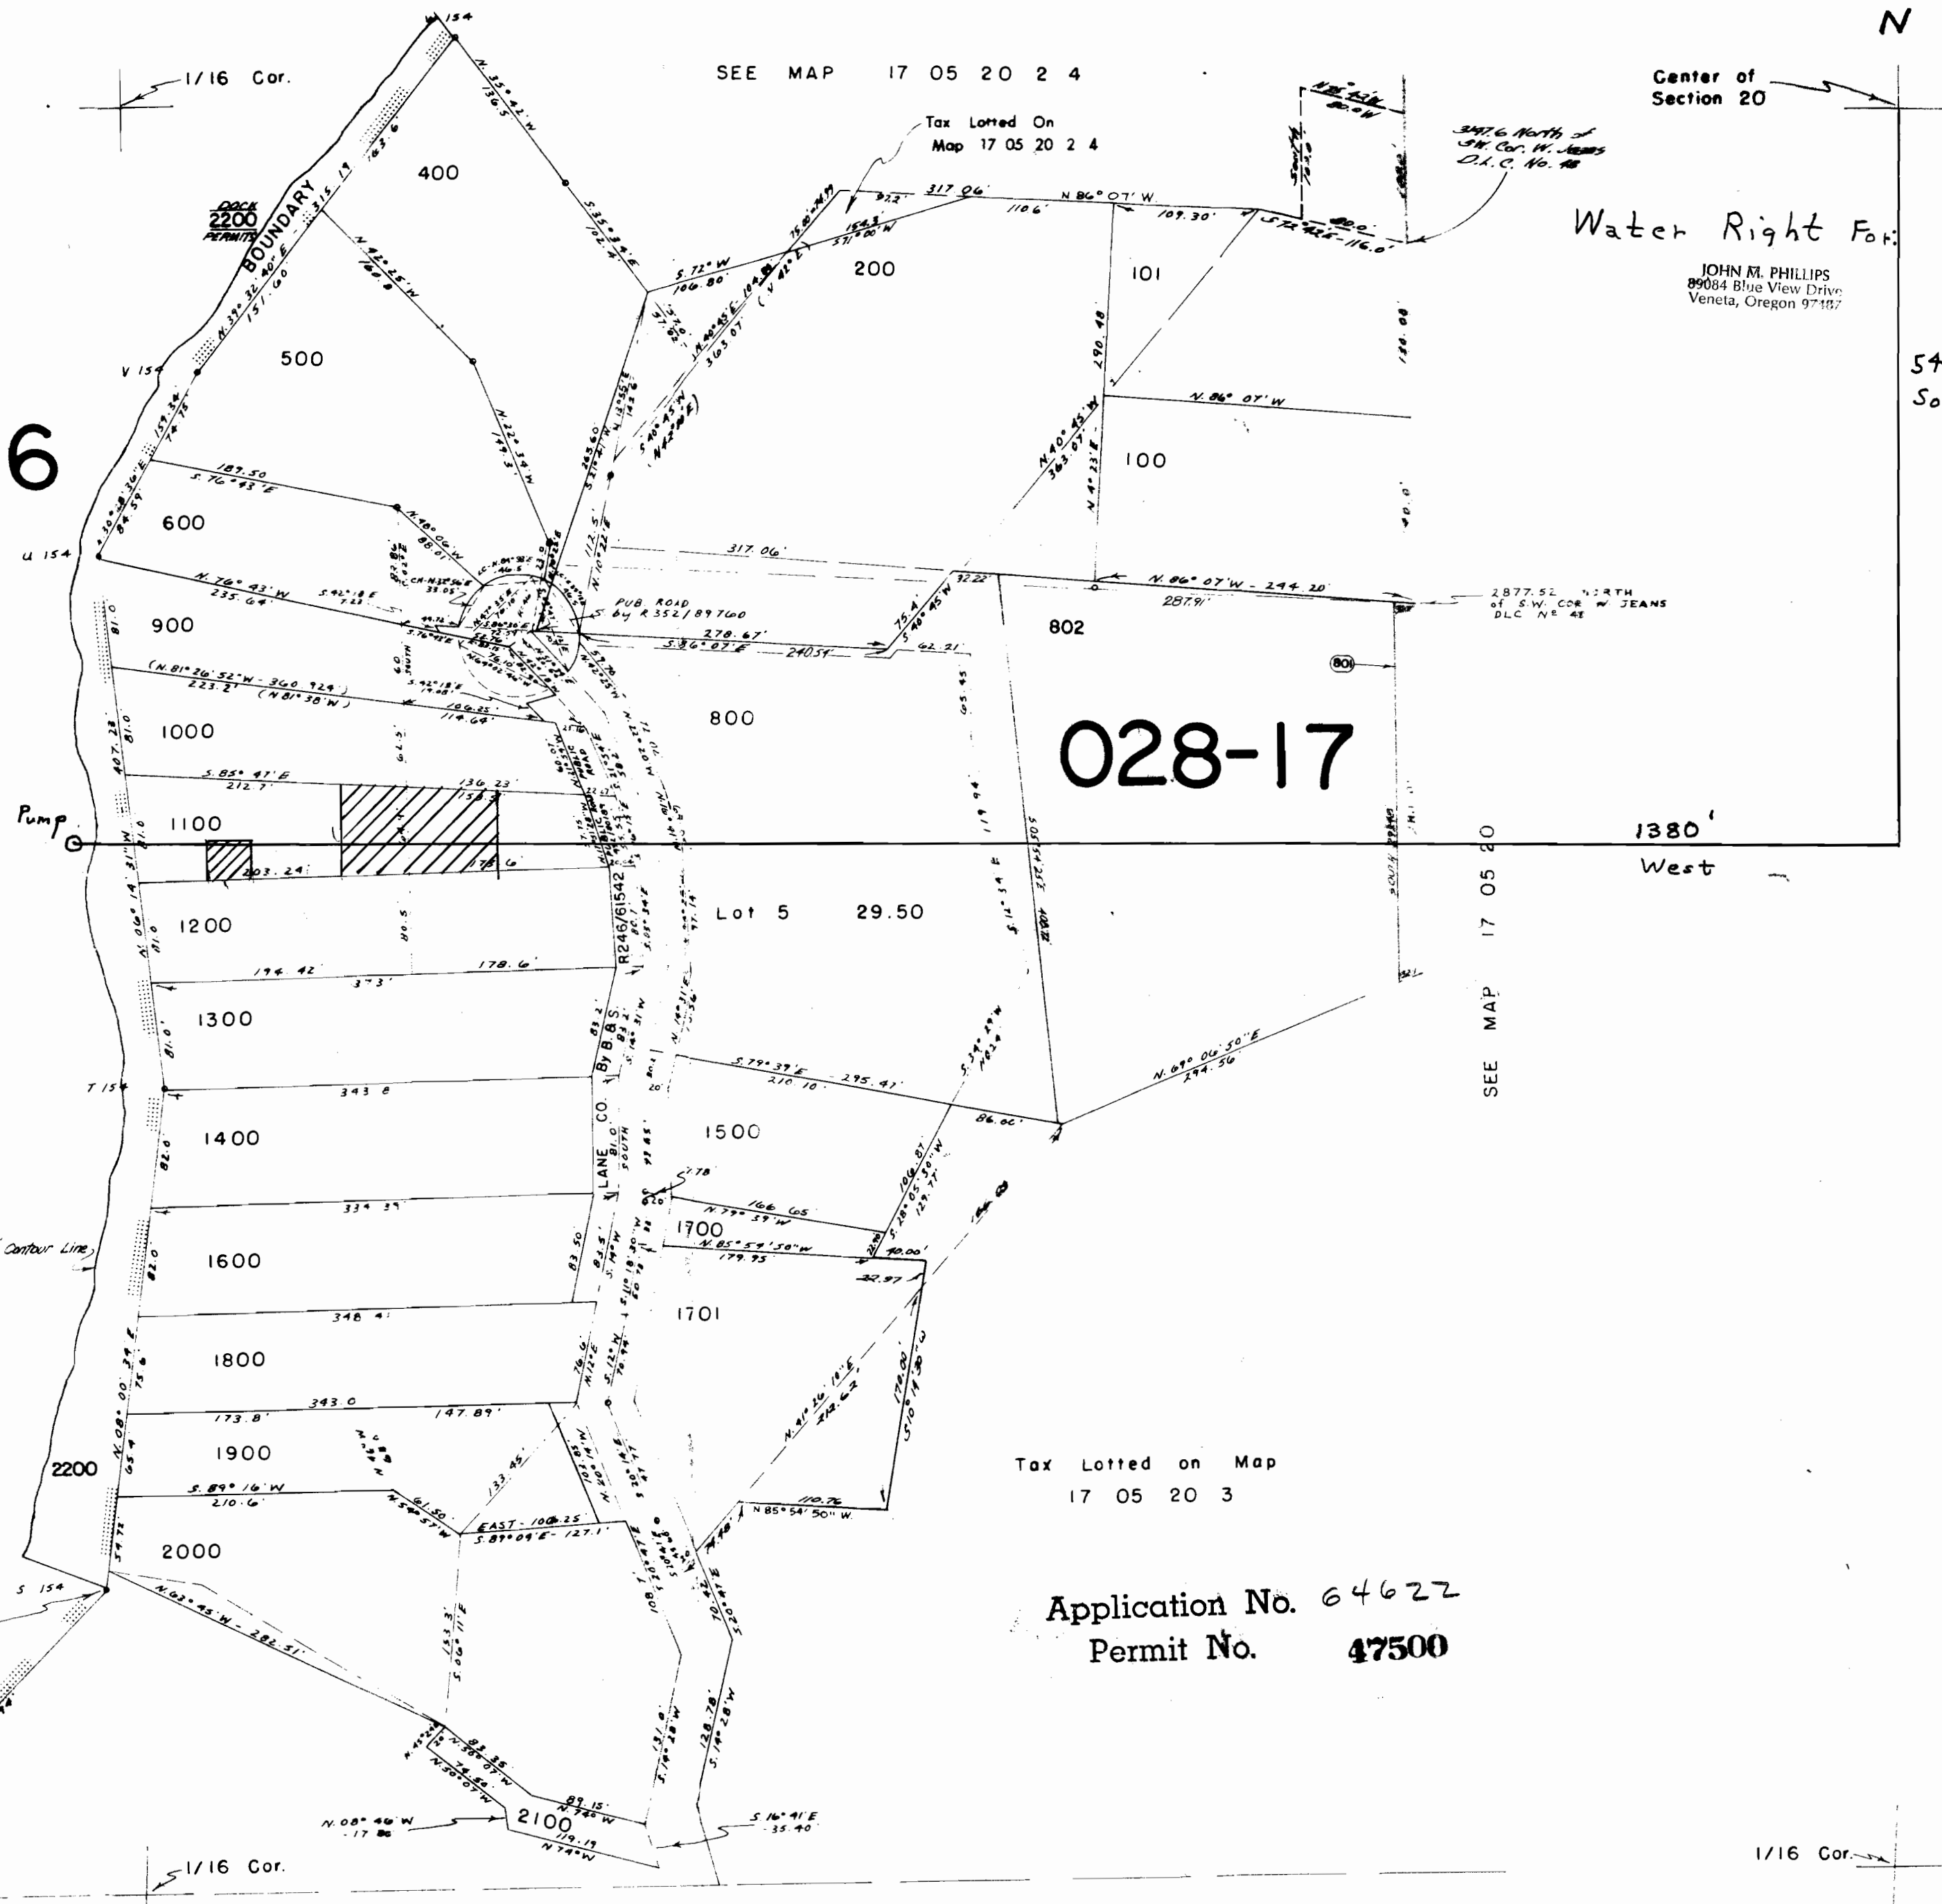

SEE MAP 17 05 20 2 4

Tax Lotted On
Map 17 05 20 2 4

Center of
Section 20

Water Right For:

JOHN M. PHILLIPS
89084 Blue View Drive
Veneta, Oregon 97137

545'
South

028-17

SEE MAP 17 05 20

1380'
West

Tax Lotted on Map
17 05 20 3

Application No. 64622
Permit No. 47500

SEE MAP 17 05 20 3

1/16 Cor.