


T. 16 & 17 S., R. 6 & 7 W., W.M.

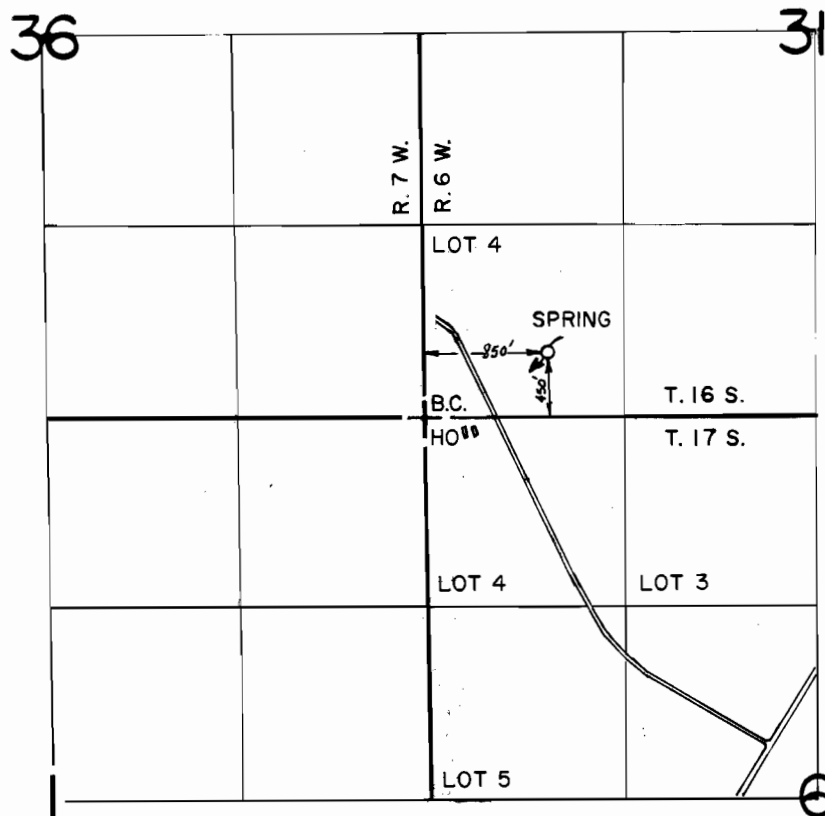

SCALE: 1" = 1320'

FINAL PROOF SURVEY UNDER

Application No. 66663 Permit No. 48452
IN NAME OF

DYLE J. LINN ESTATE

Surveyed MAY 8 1985, by P.R. PAGTER