


T.9S.,R.9W.,W.M.

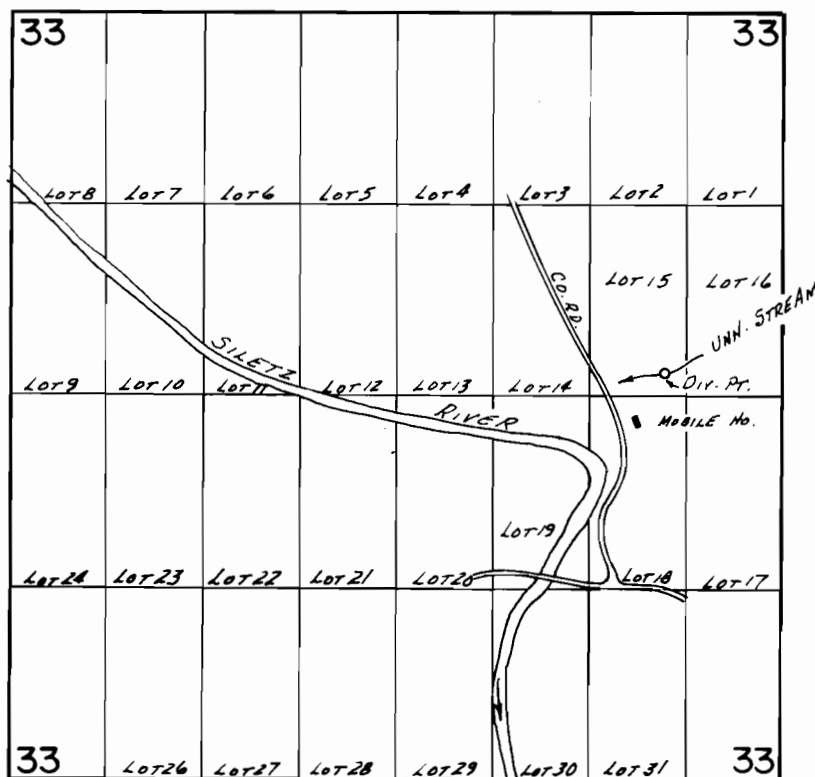

Dir. Pt. Loc.: 2800' N. & 800' W. FROM SE COR. SEC. 33.

SCALE: 1"=1320'

FINAL PROOF SURVEY UNDER

Application No. 56109.... Permit No. 42394....
IN NAME OF

.....CARL E. KENTTA.....

Surveyed Sept. 10... 1984, by B.W. BISHOP....