


T.11S., R.1W., W.M.

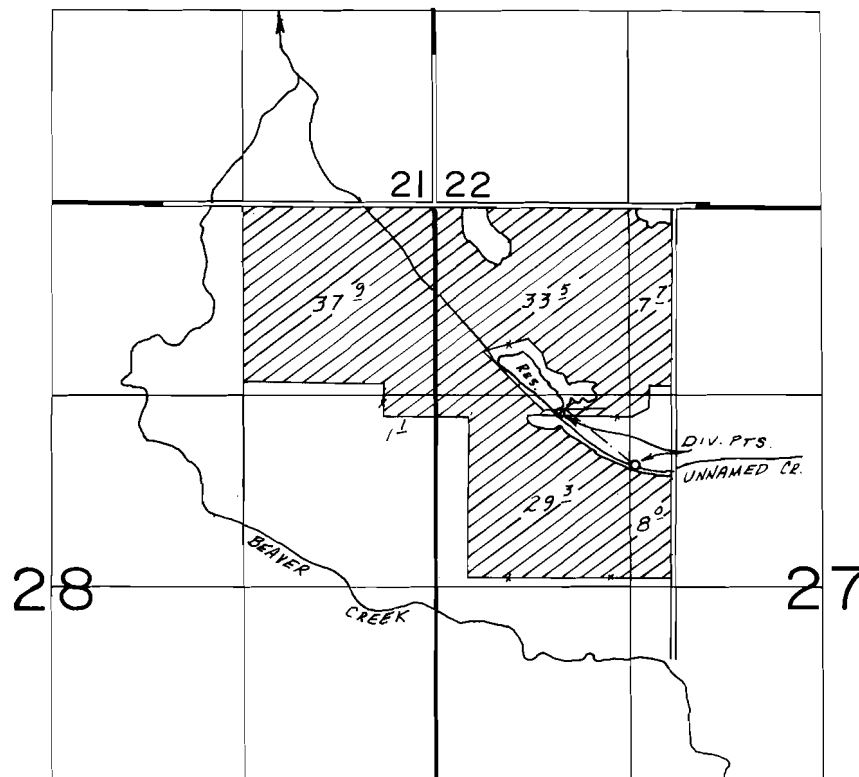

DIV. PTS. LOC.: UNNAMED CREEK- 1775'S. & 1365'E., RESERVOIR-
1470'S & 850'E, BOTH FROM NW COR. SEC. 27.

SCALE: 1"=1320'

FINAL PROOF SURVEY UNDER

R-56373 R-6636
Application No. 56374 Permit No. 41966.....
IN NAME OF

.....WAYLAND G. & FAY L. SMALL.....

Surveyed June 8... 1984, by L. M. TOLL.....

End
PTS 1984 (ENDURO)
INSPECTION