


T.10S., R.3W., W.M.

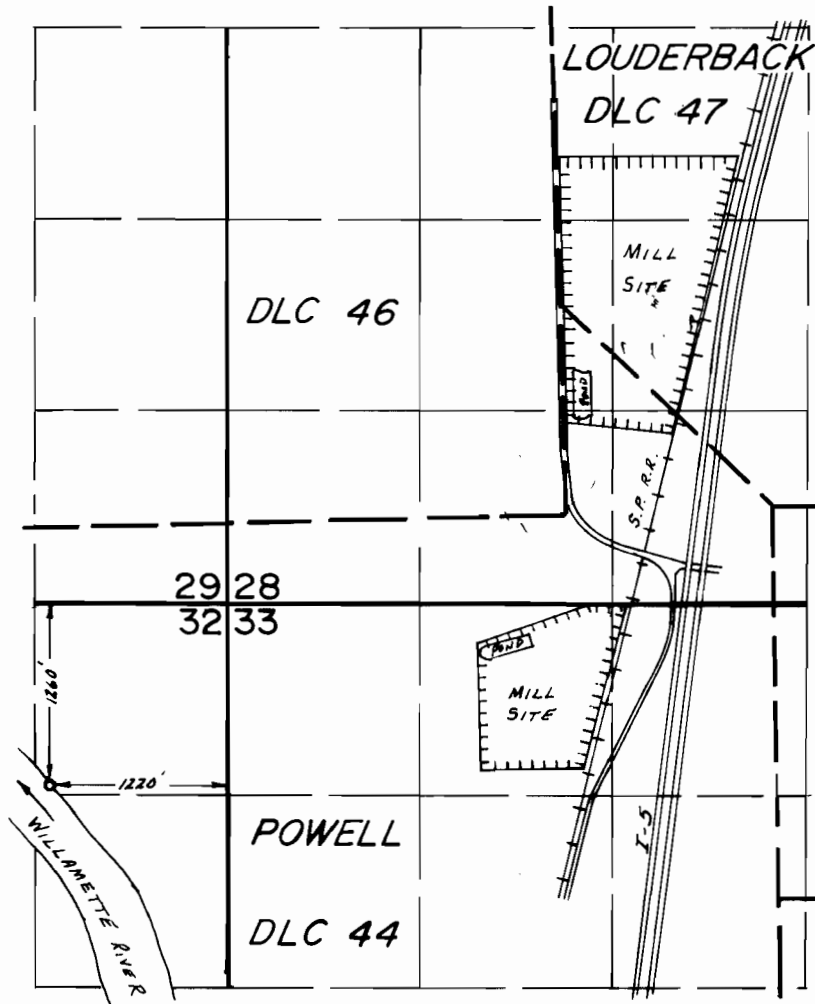

SCALE: 1"=1320'

FINAL PROOF SURVEY
UNDER

Application No. 29640... Permit No. 23102.....

IN NAME OF
WILLAMETTE INDUSTRIES, INC.
.....(ALBANY PAPER MILL).....

Surveyed May 4..... 1984, by L.M.TOLL.....