


T. 10S., R. 2W., W.M.

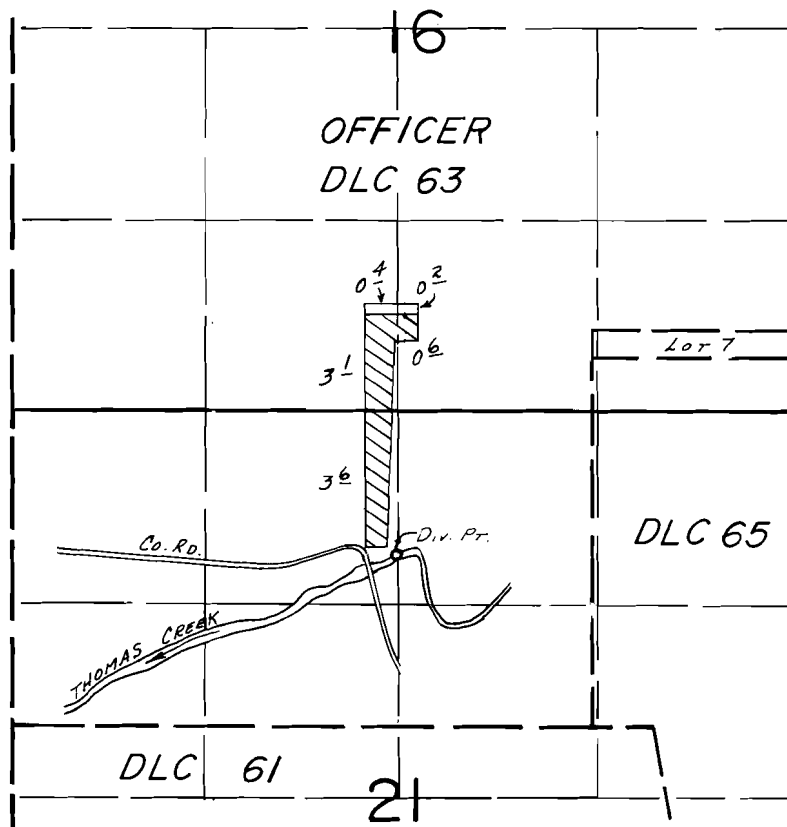

DIV. PT. LOC.: 970' S. & 20' W. FROM N¹/₄ COR. SEC. 21.

SCALE: 1" = 1320'

FINAL PROOF SURVEY
UNDER

Application No. 60273.. Permit No. 45094.....
IN NAME OF

.....LARRY P. SYDOW.....

Surveyed May 31.... 19.84, by L.M.TOLL.....