


T. 9S., R. 1W., W.M.

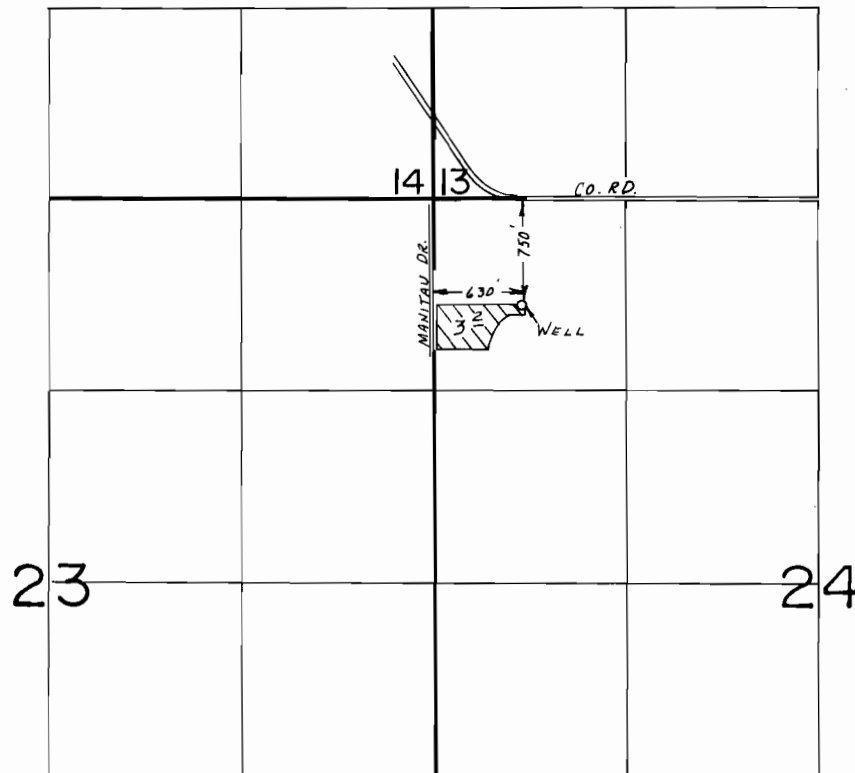

SCALE: 1" = 1320'

FINAL PROOF SURVEY UNDER

Application No. G-9325. Permit No. G-8689....
IN NAME OF

MARION D. & BARBARA J. BOCKELMAN

Surveyed May 31... 1984, by L.M. TOLL.....