


T.7S.R.1E.W.M.

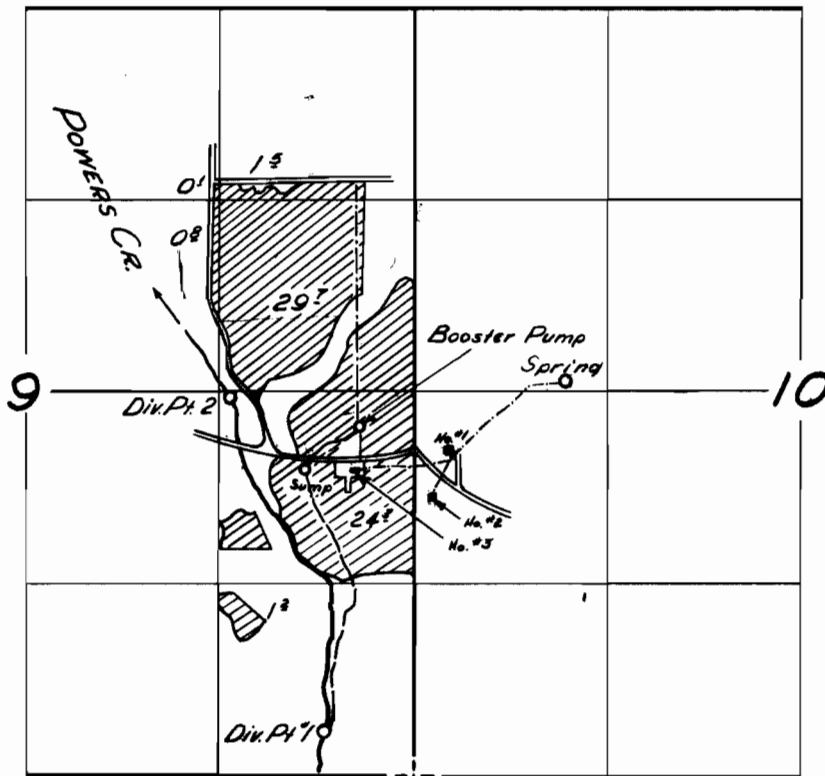

**FINAL PROOF SURVEY**

UNDER

Application No. 19206 Permit No. 14800

IN NAME OF

FRANK E. GILPATRICK

Surveyed 24 May 1956, by [Signature]