


T.6S., R.1E., W.M.

Use this map  
for f.p. map  
for transfer to be  
made (change in  
Pt. of Div.)

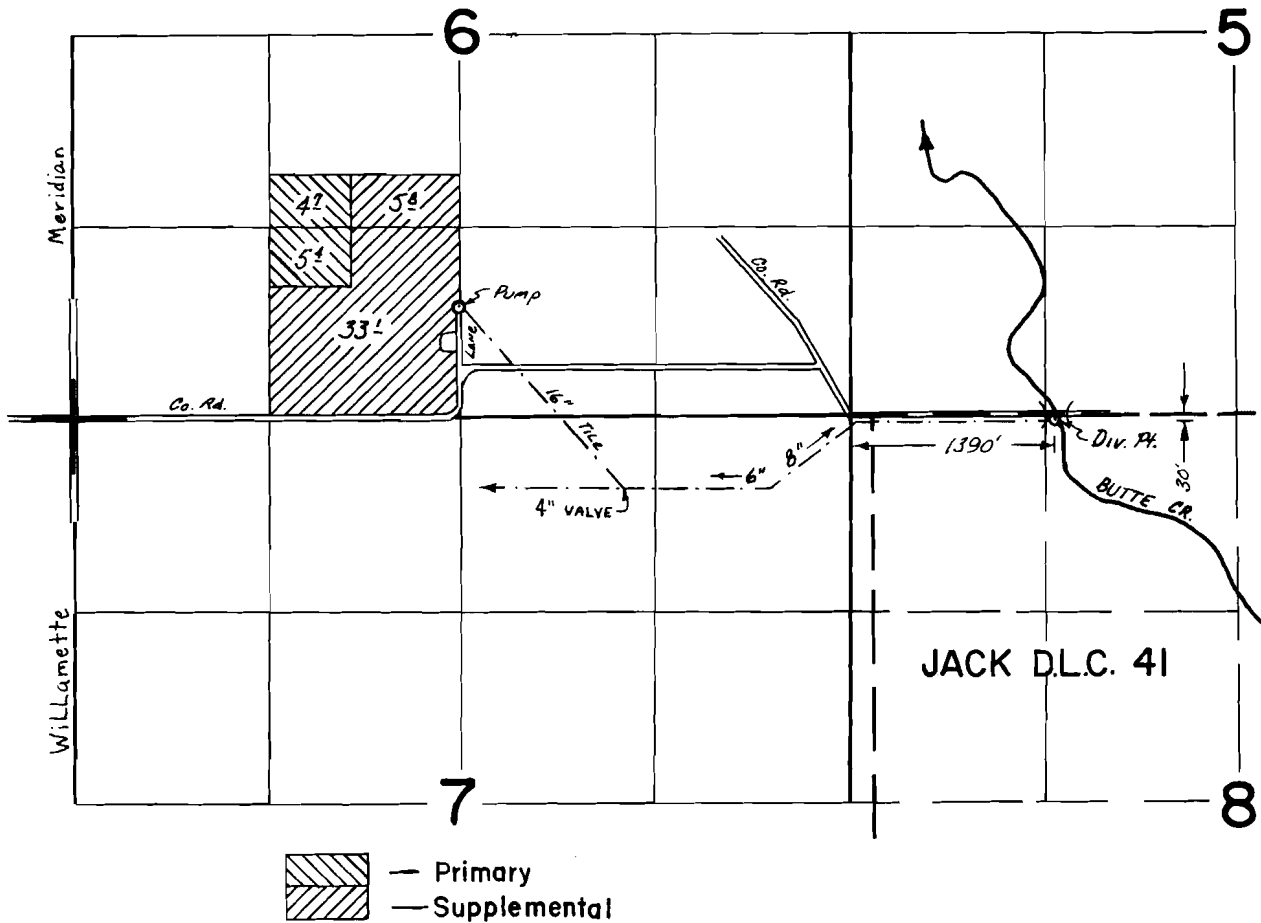


**FINAL PROOF SURVEY**  
UNDER

Application No. 45055 Permit No. 33670  
IN NAME OF

**HERMAN GOSCHIE**

Surveyed Oct. 13 1972, by R.G. Mucken

T.6S., R.1E., W.M.

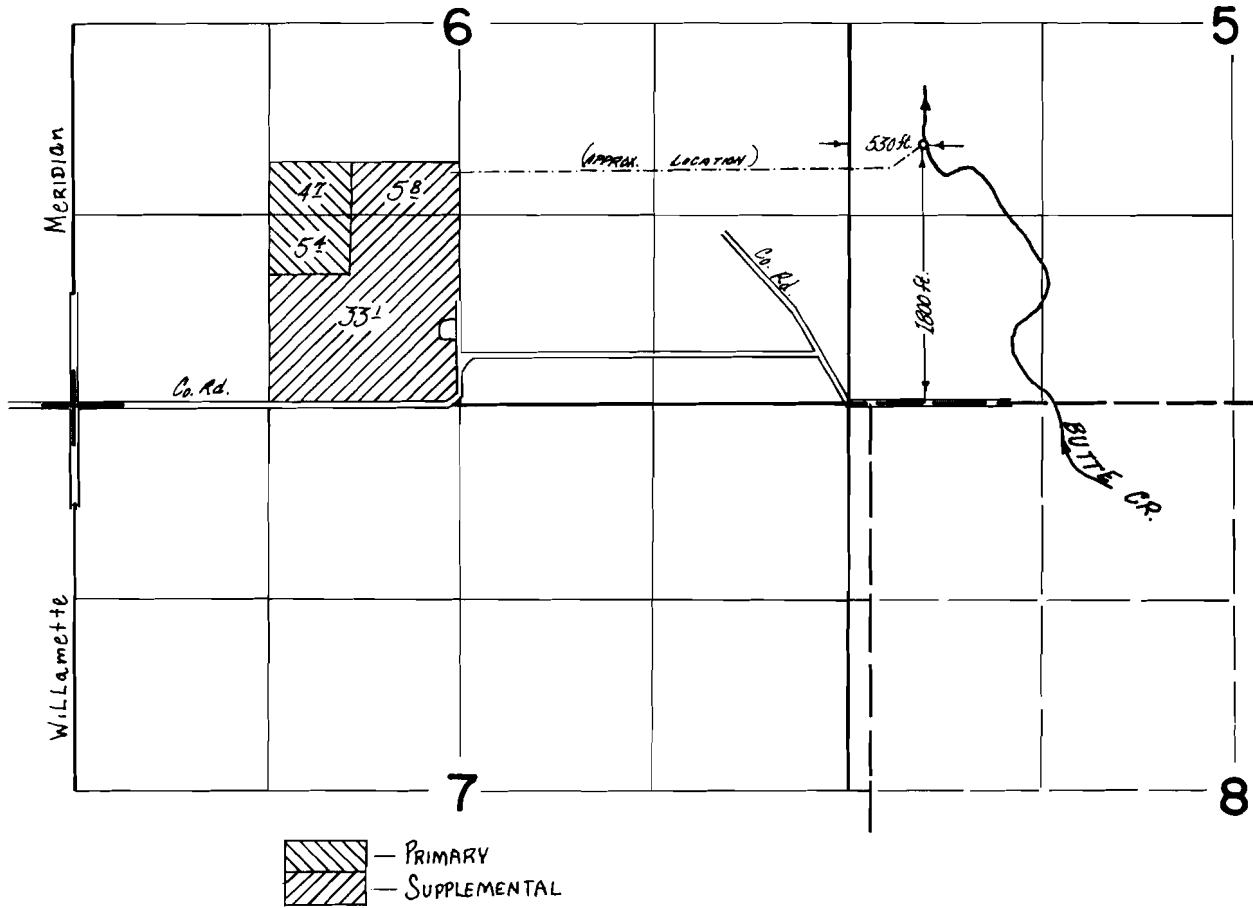

**FINAL PROOF SURVEY**  
UNDER

Application No. 45055 Permit No. 33670  
IN NAME OF

.....HERMAN GOSCHIE.....

Surveyed 13 Oct. 1972, by R. MUCKEN