


# T.7S., R.2W., W.M.

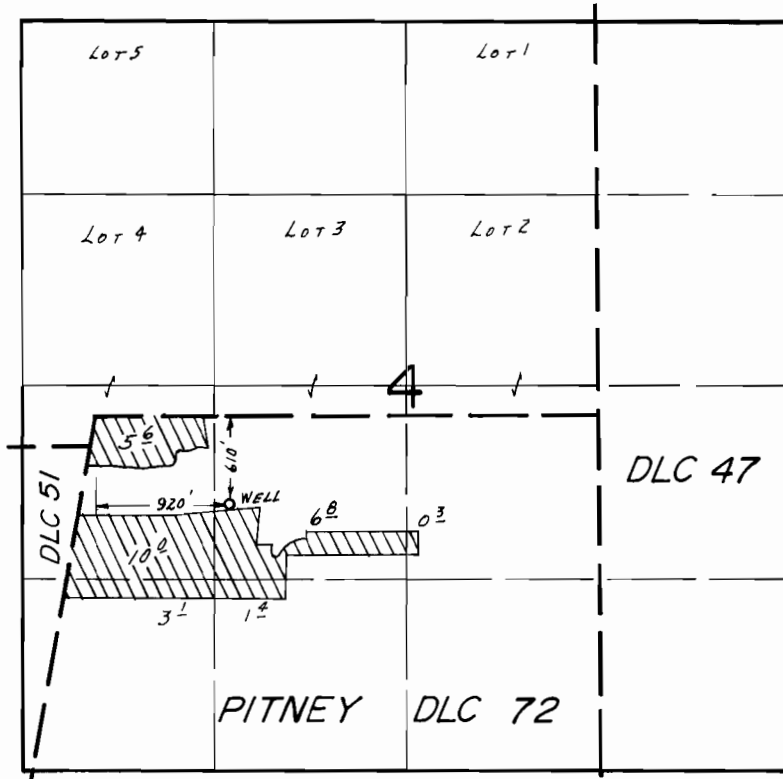

SCALE: 1" = 1320'

## FINAL PROOF SURVEY UNDER

Application No. G-9106... Permit No. G-8607....  
IN NAME OF

.....DORIS NEEDHAM.....

Surveyed July 2..... 1984, by B.W. BISHOP.....