


T.9S.R.3W.W.M.

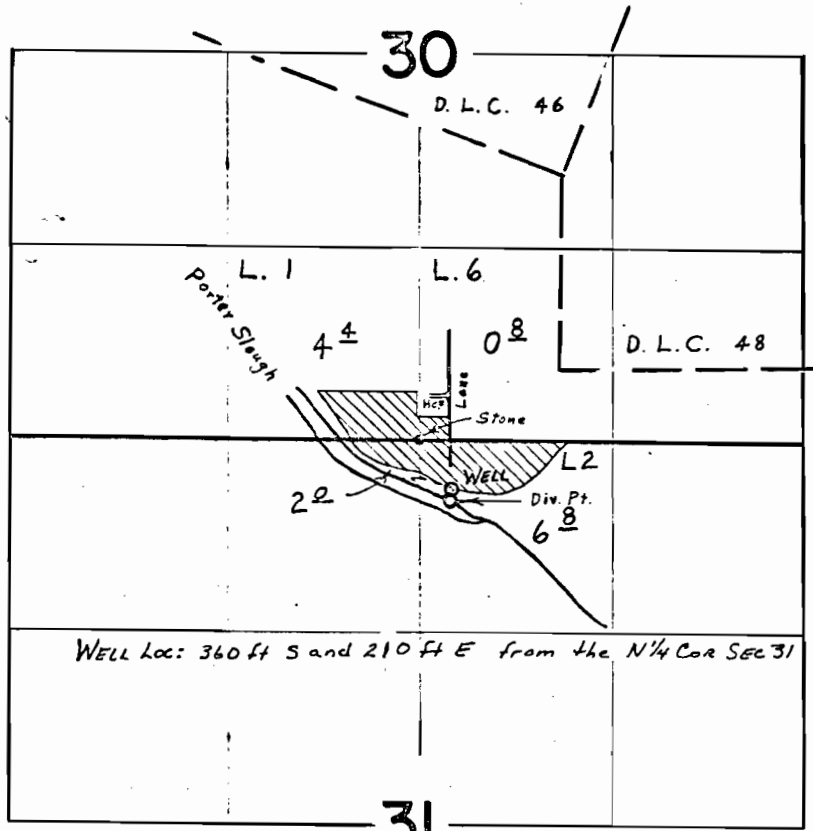

Div. Pt. Located 410' S. & 210' E. From The N. 1/4 Cor. Sec. 31

Application Map for

DARRELL A. LEARN

Application No. G-7498
Permit No. G 9935