


T. 7 S. R. 5 W. W. M.

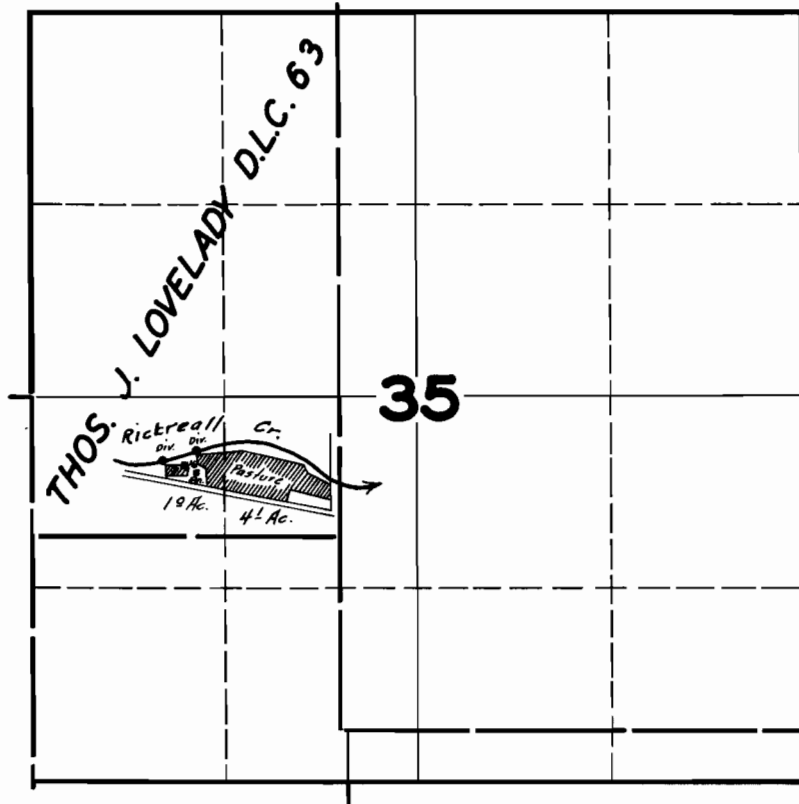

**FINAL PROOF SURVEY
UNDER**

Application No. 19676 Permit No. 15256

**IN NAME OF
CARL B. KREFT**

Surveyed MAR. 4 1946, by *[Signature]*