





T.1S.,R.3W.,W.M.

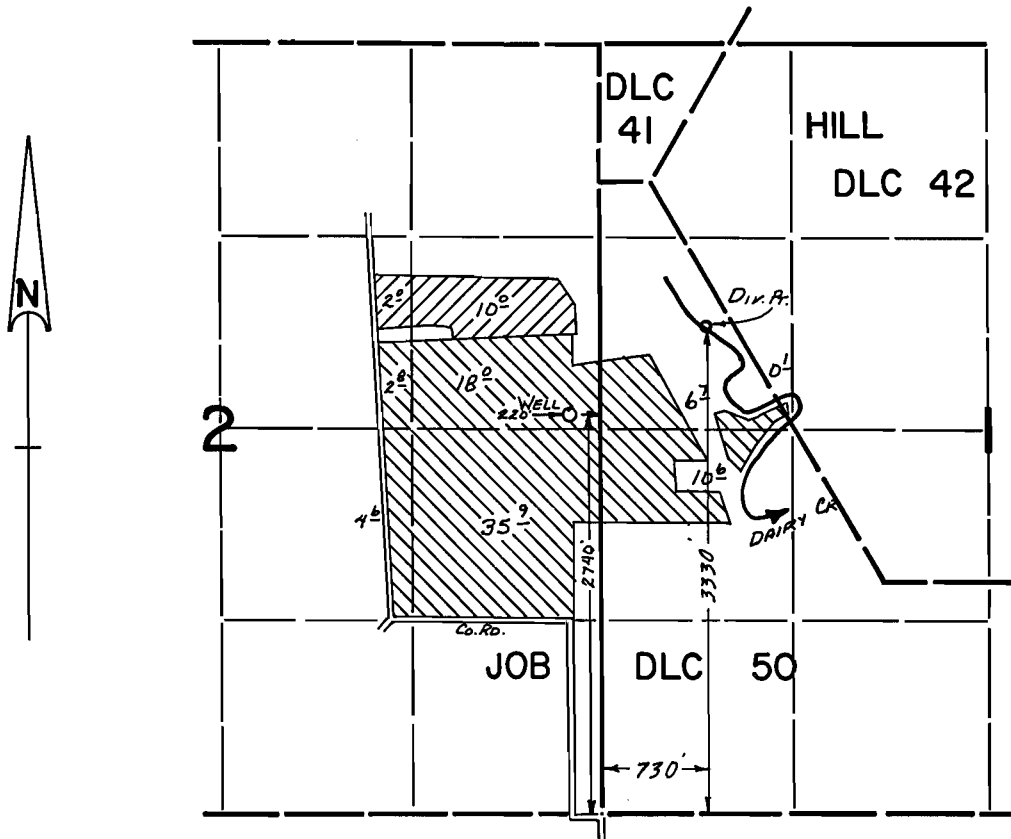

SCALE: 1" = 1320'

FINAL PROOF SURVEY UNDER

61709 45791  - Supplemental
 Application No. G-7571.. Permit No. G-7031..  - Pri.  - Supp'l
 IN NAME OF

.....GERALD VAN DYKE.....

Surveyed Nov. 3, 1983, by L. M. TOLL.....
 Aug. 23, 1984, B. W. BISHOP