Form A1-187
March 1961

UNITED STATES
DEPARTMENT OF THE INTERIOR
BUREAU OF LAND MANAGEMENT

SECTION
S26

Oregon State Water Filings

TOWNSHIP 30S, RANGE 45E, W. M.

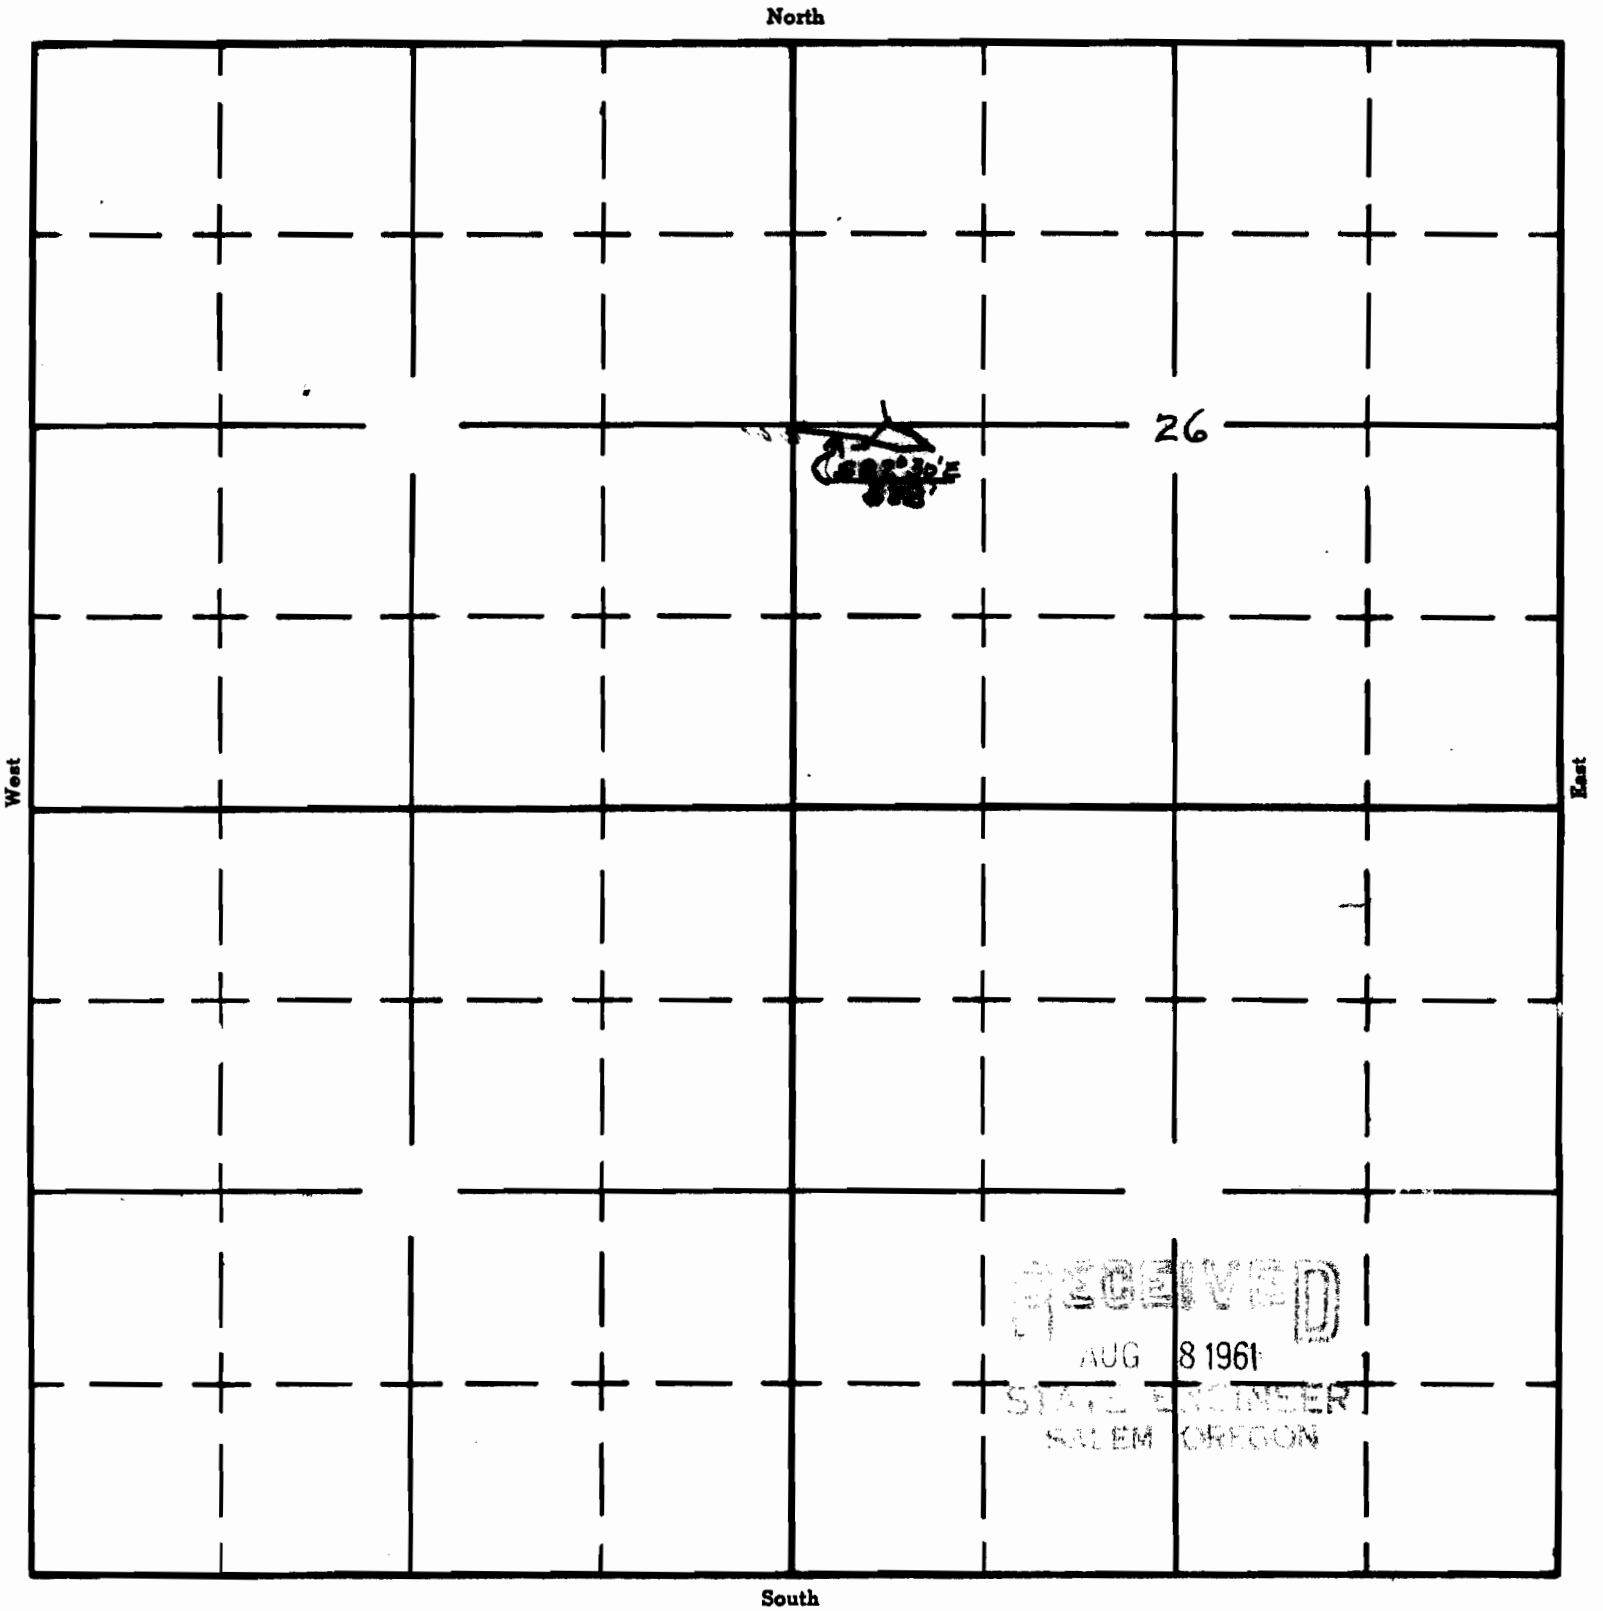

RECEIVED
AUG 8 1961
STATE ENGINEER
SALEM, OREGON

APPLICATION No. R-36636
PERMIT No. R 7261