


18	17	16	15	14		
19	20	21	22	23		
20	29	28	27	26		
31	32	33	34	35		

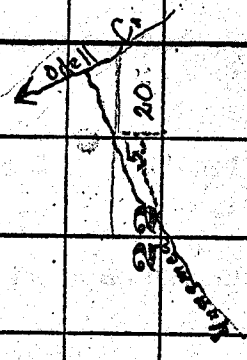

DEPT. OF STATE
 RECEIVED
 AUG 21 19
 SALEM, ORE.

Application No. 7483
 Permit No. 4748

4748

FROM OFFICE OF THE STATE ENGI
 T. N. R. O E
 Scale of Feet.