

UNITED STATES
DEPARTMENT OF THE INTERIOR
BUREAU OF LAND MANAGEMENT


SECTION 13

Oregon State Water Filings

TOWNSHIP 19S, RANGE 38E, W. M.

Becker's Res.

North

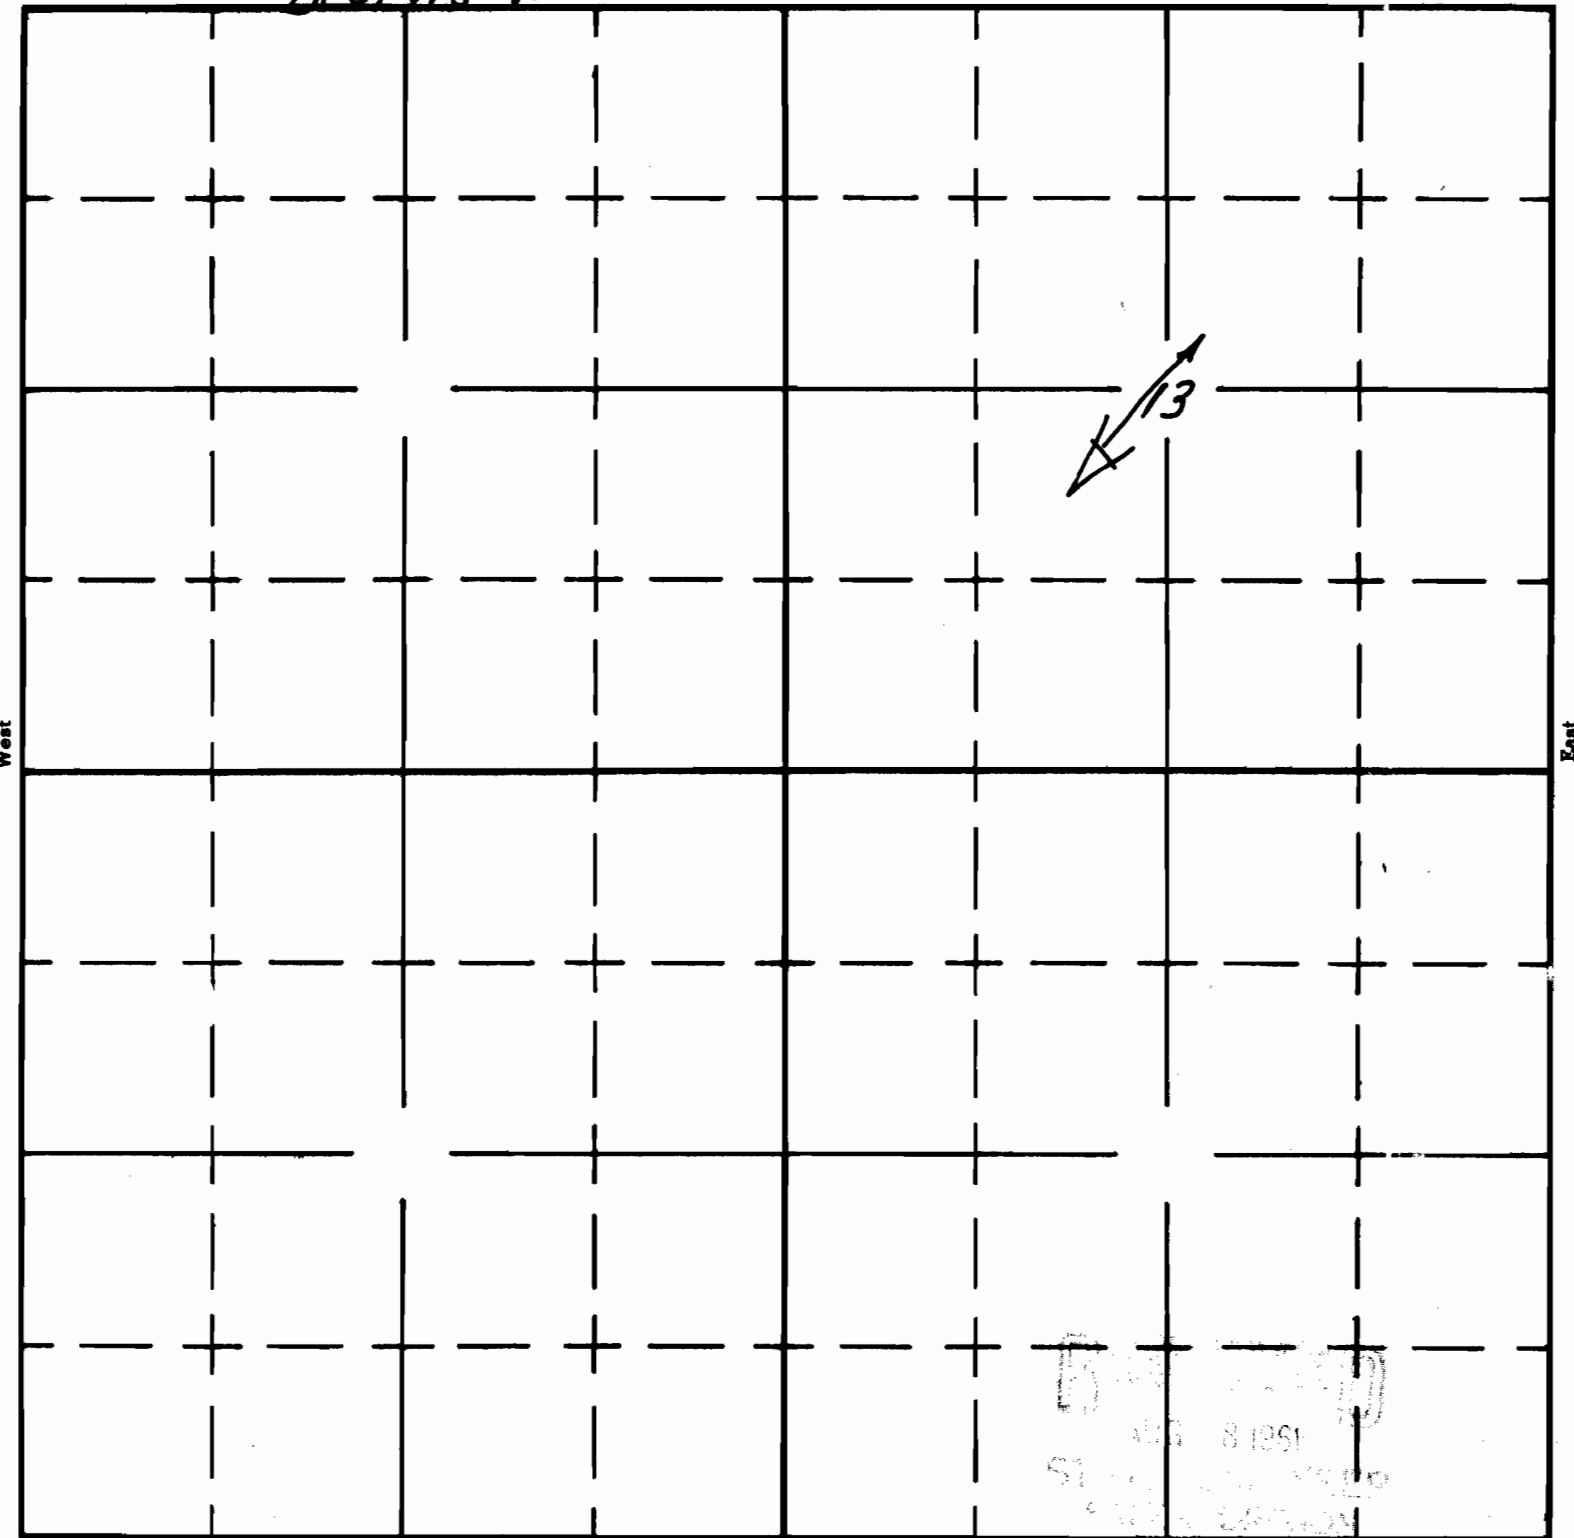

South

APPLICATION No. **R-36904**
PERMIT No. **R 7412**