

UNITED STATES
DEPARTMENT OF THE INTERIOR
BUREAU OF LAND MANAGEMENT


SECTION 36

Oregon State Water Filings

TOWNSHIP 185, RANGE 38E, W. M.

Corral Res

North

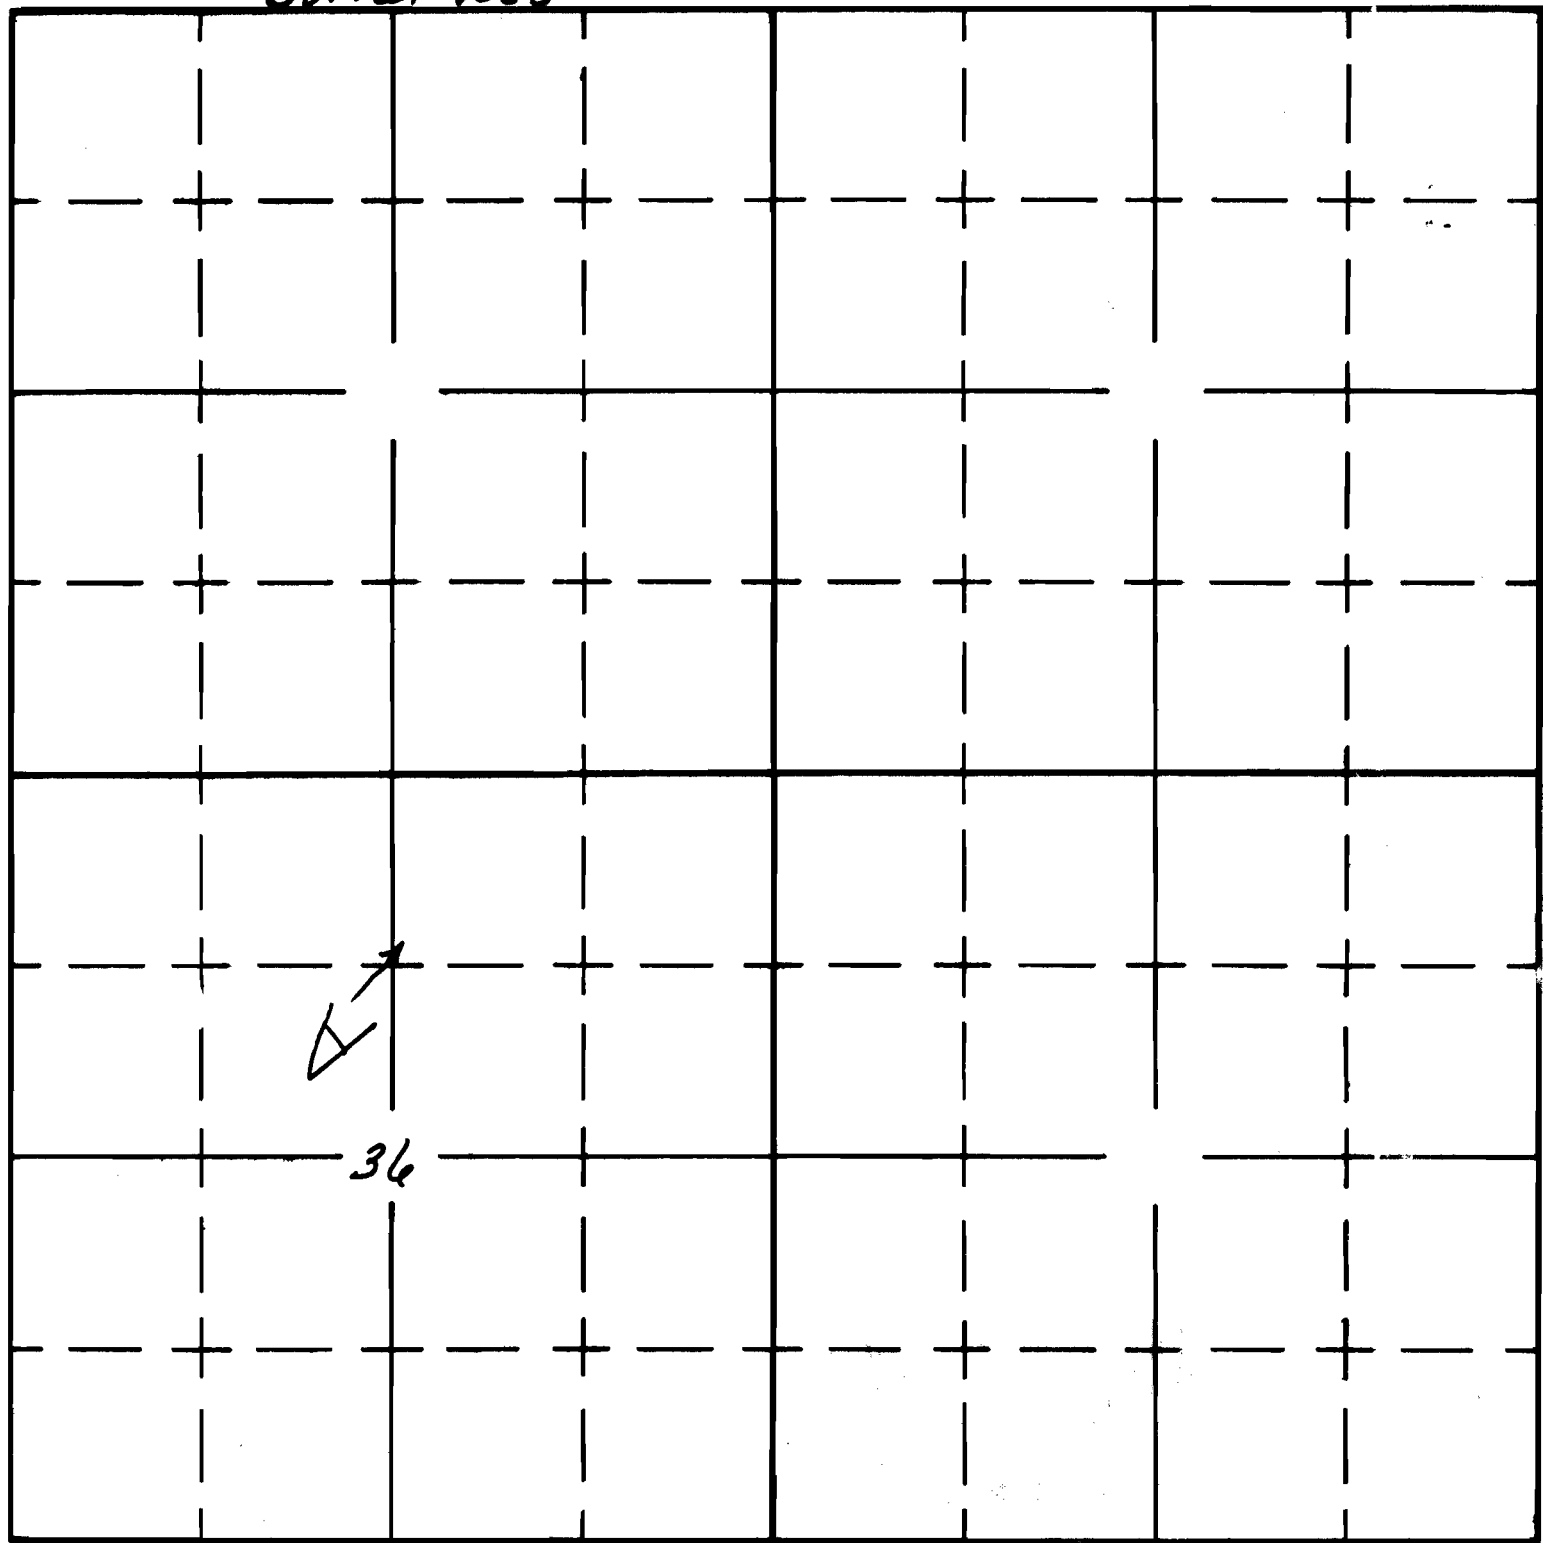

West

East

South