

UNITED STATES
DEPARTMENT OF THE INTERIOR
BUREAU OF LAND MANAGEMENT


SECTION 18

Oregon State Water Filings

TOWNSHIP 19S, RANGE 40E, W. M.

Pense Spring Res.

North

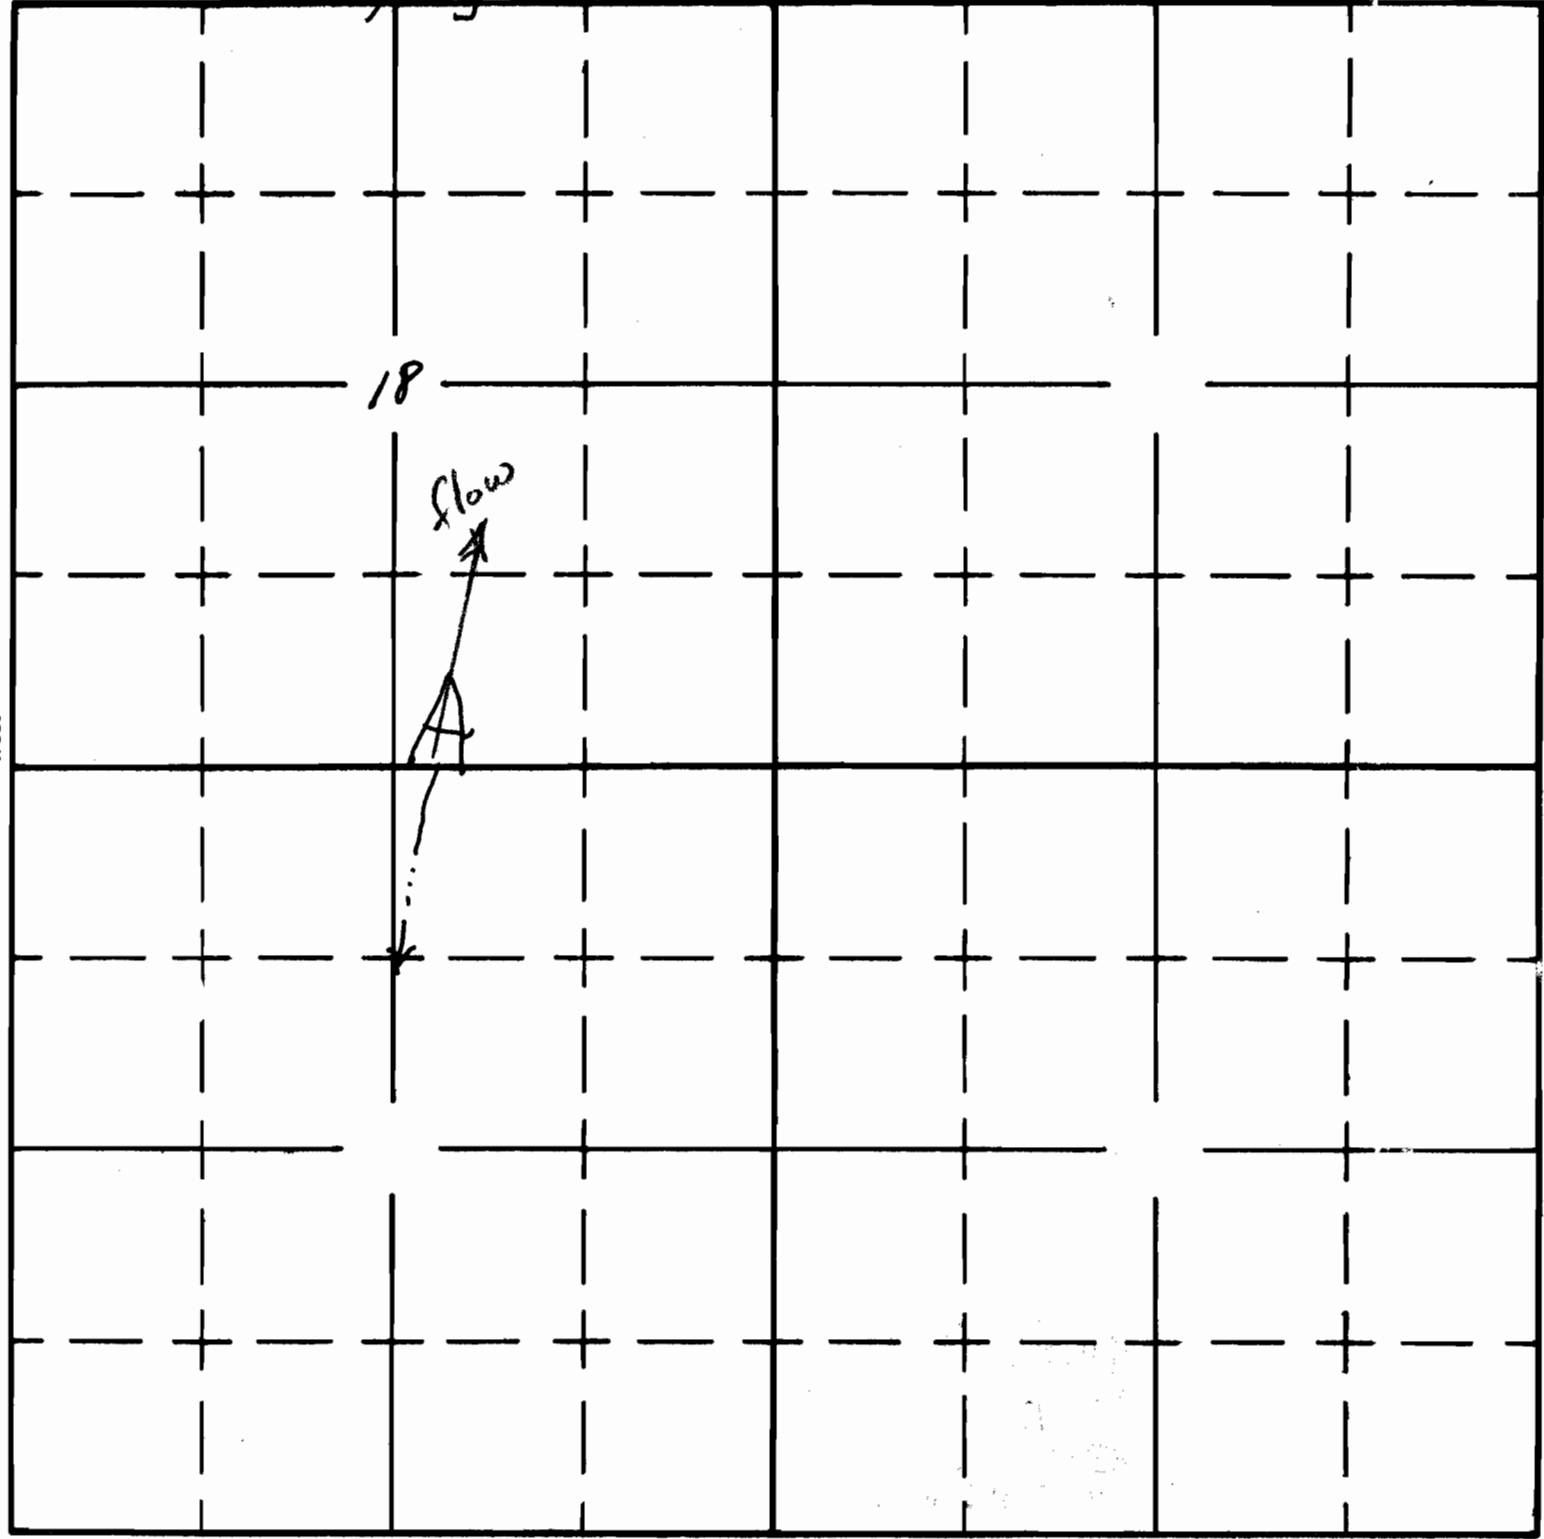

South