


Form AI-187
March 1961

UNITED STATES
DEPARTMENT OF THE INTERIOR
BUREAU OF LAND MANAGEMENT

SECTION
SE⁴ NE⁴
Sec 29

Oregon State Water Filings

TOWNSHIP 22 S, RANGE 42 E, W. M.

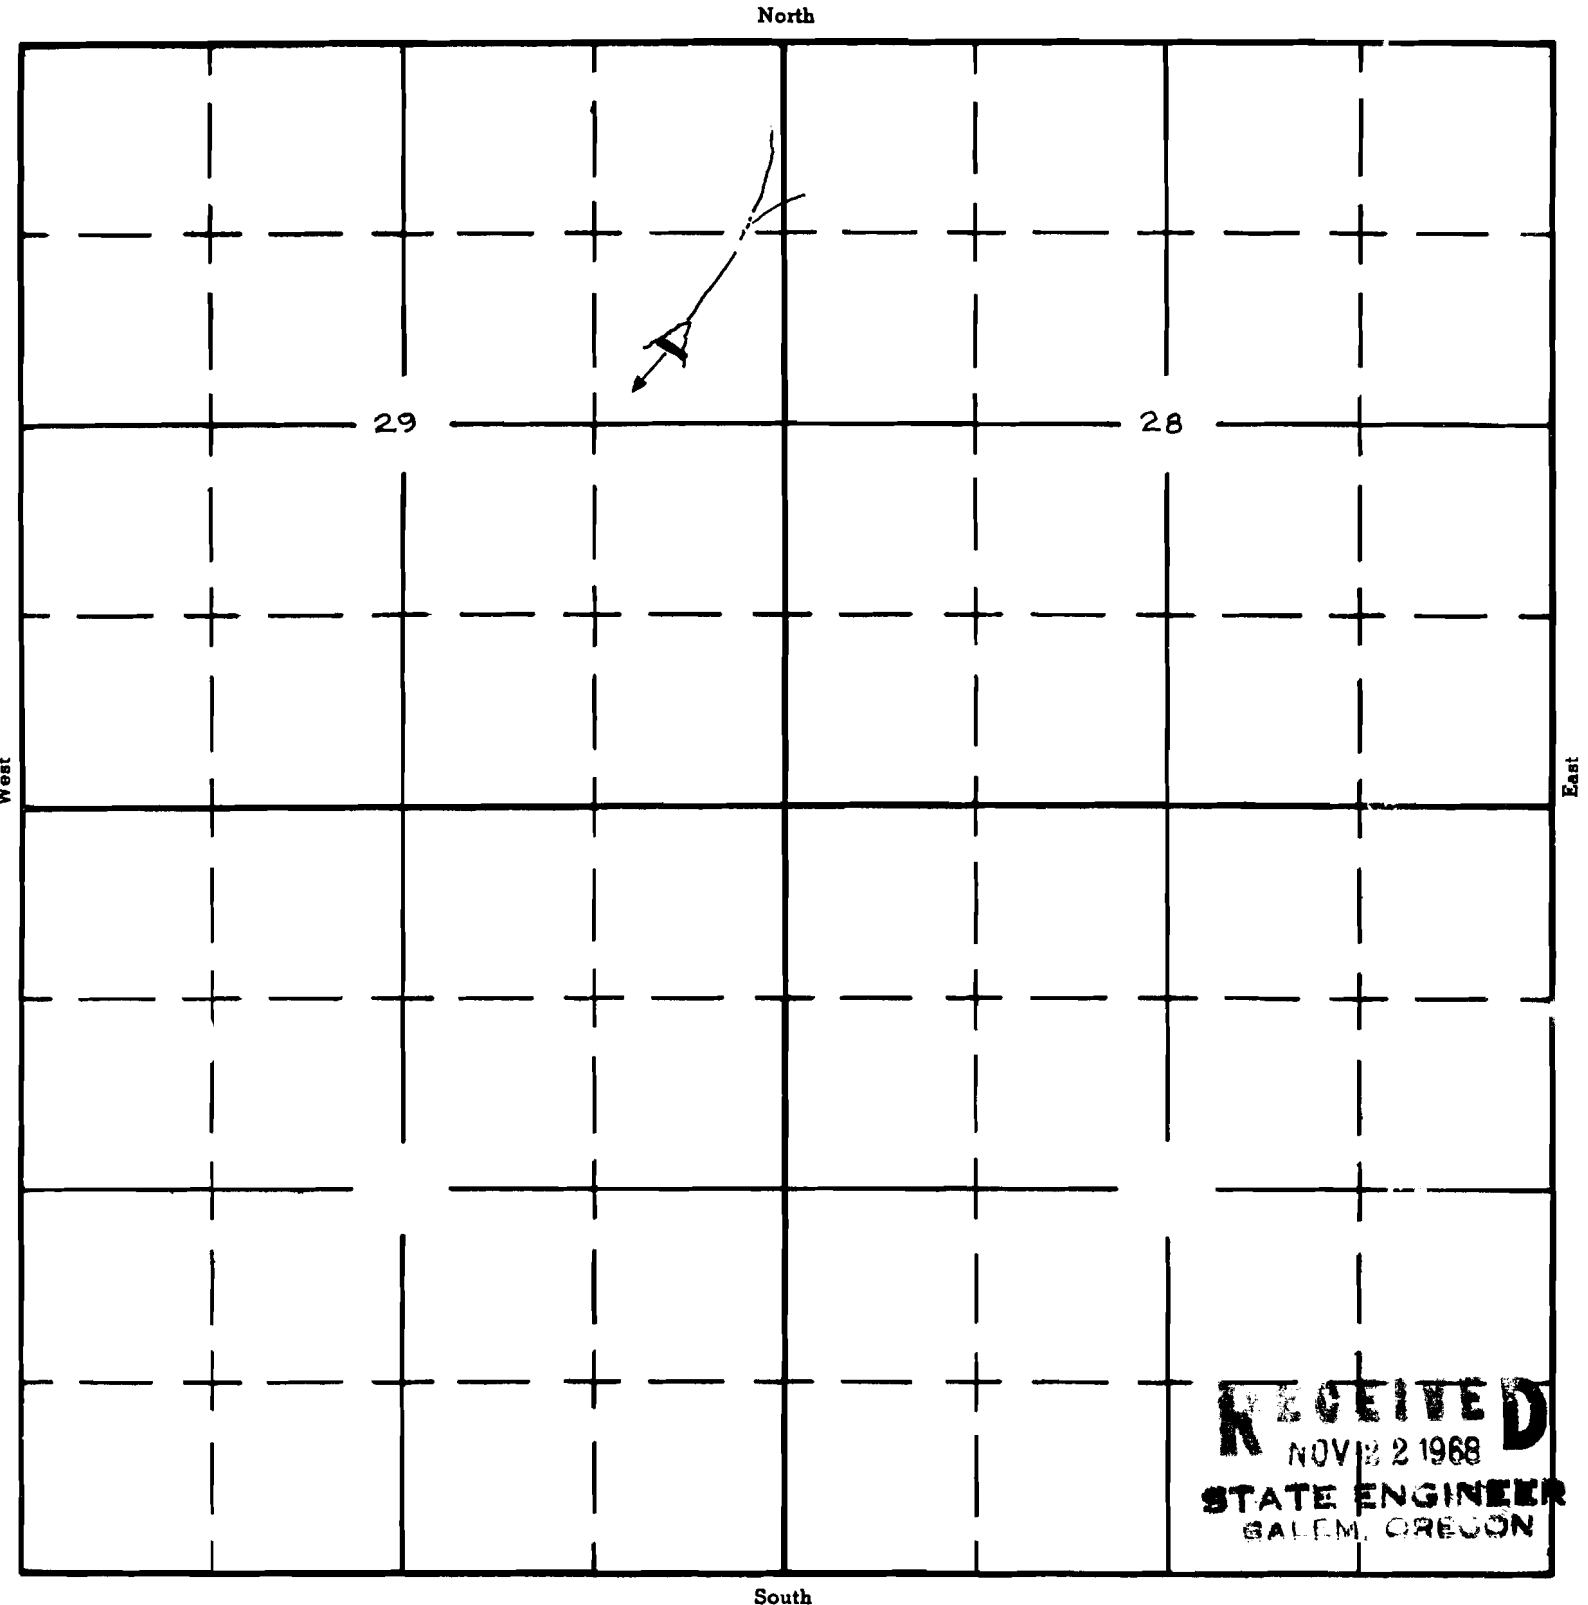

RECEIVED
NOV 2 1968
STATE ENGINEER
GALE, OREGON

Slim & Fatty Res.

APPLICATION No. R 45562
PERMIT No. R 7427