

Form AI-187
March 1961

UNITED STATES
DEPARTMENT OF THE INTERIOR
BUREAU OF LAND MANAGEMENT


SECTION
NW 4 SE 4
Sec. 34

Oregon State Water Filings

TOWNSHIP 24 S., RANGE 39 E., W. M.

RECEIVED
STATE ENGINEER

North

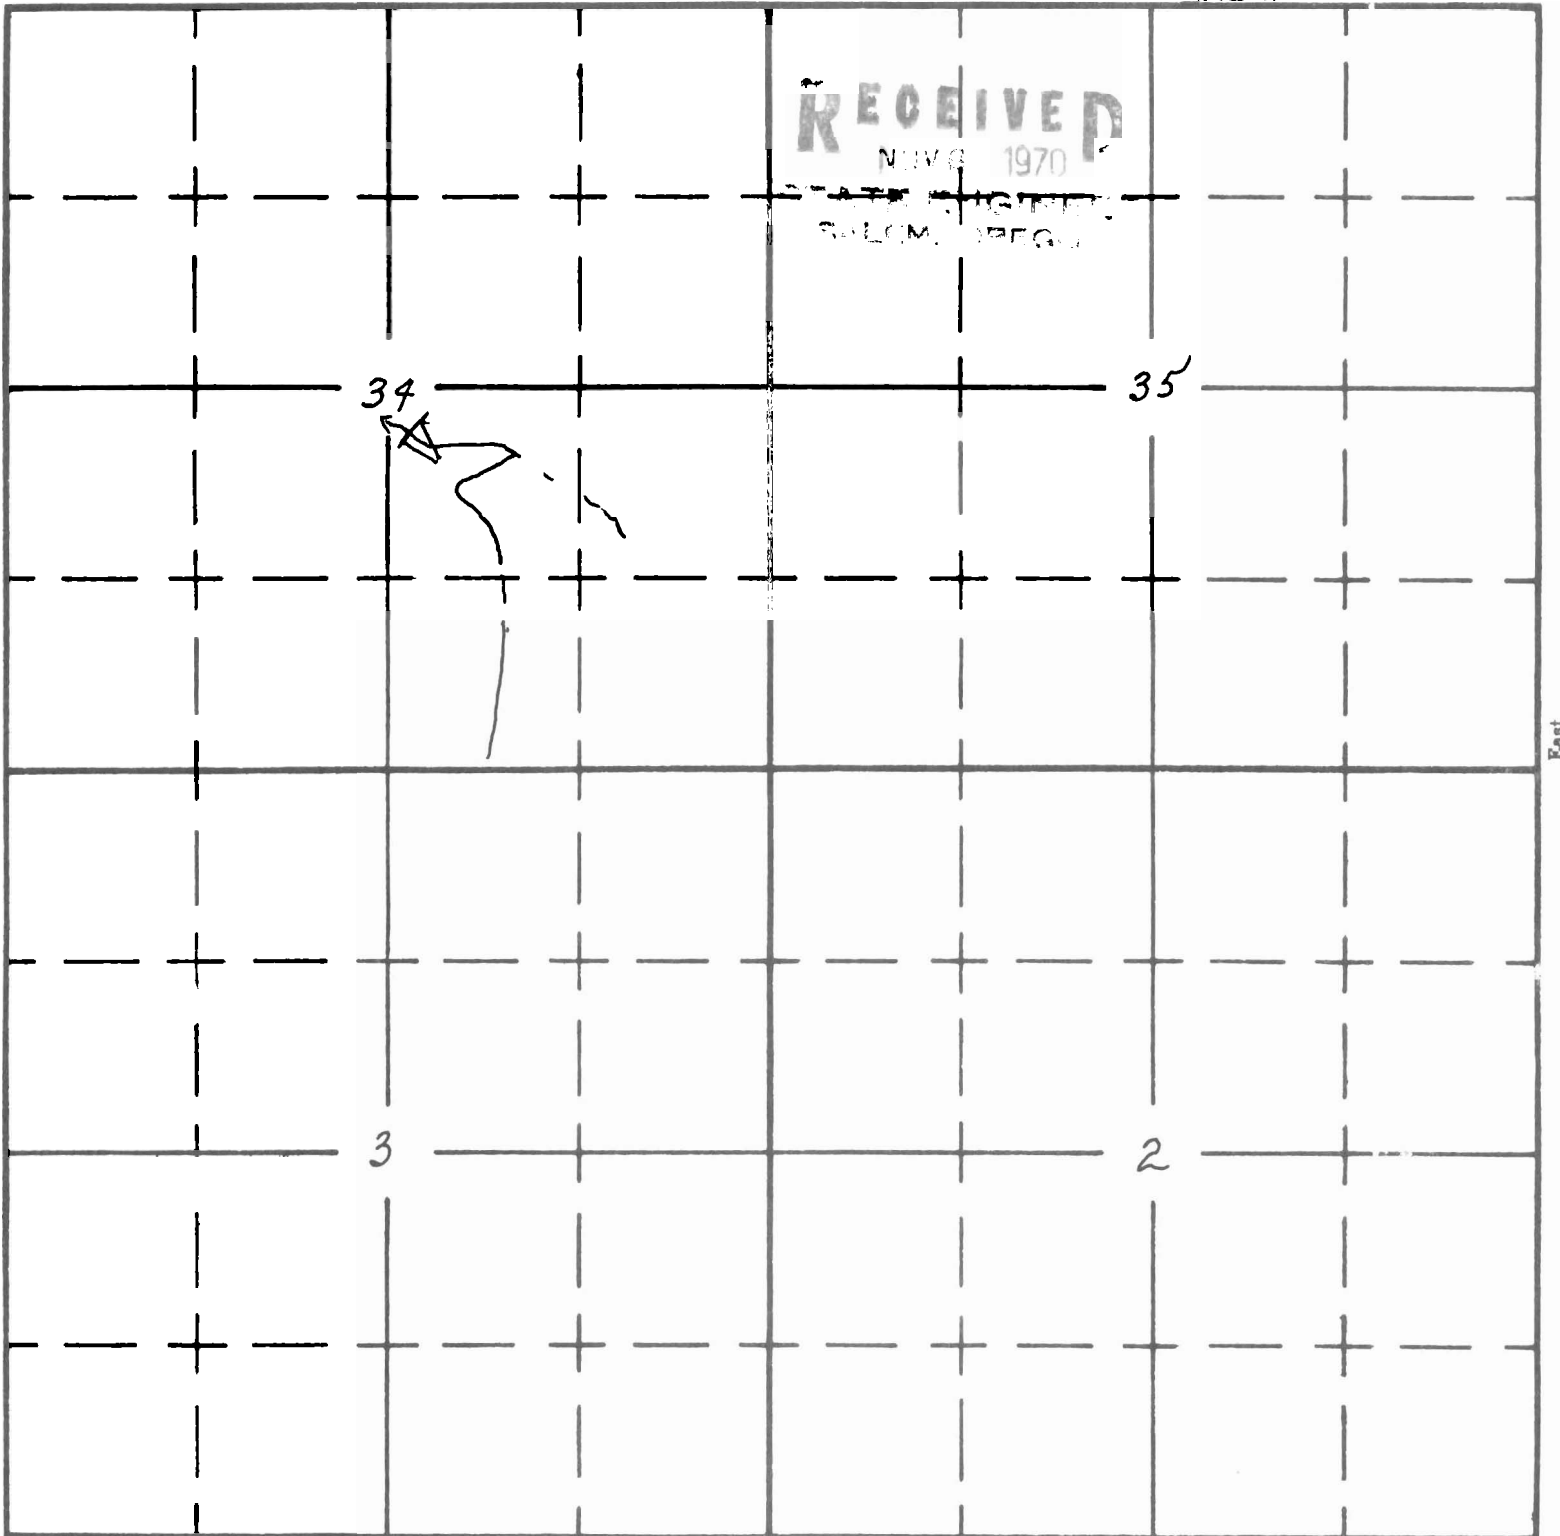

South

Sack Canyon Res.

APPLICATION No. 16726
PERMIT No. 2000