

UNITED STATES
DEPARTMENT OF THE INTERIOR
BUREAU OF LAND MANAGEMENT


SECTION

Oregon State Water Filings

NW SW
Sec. 15

TOWNSHIP 24S, RANGE 38E, W. M.

North

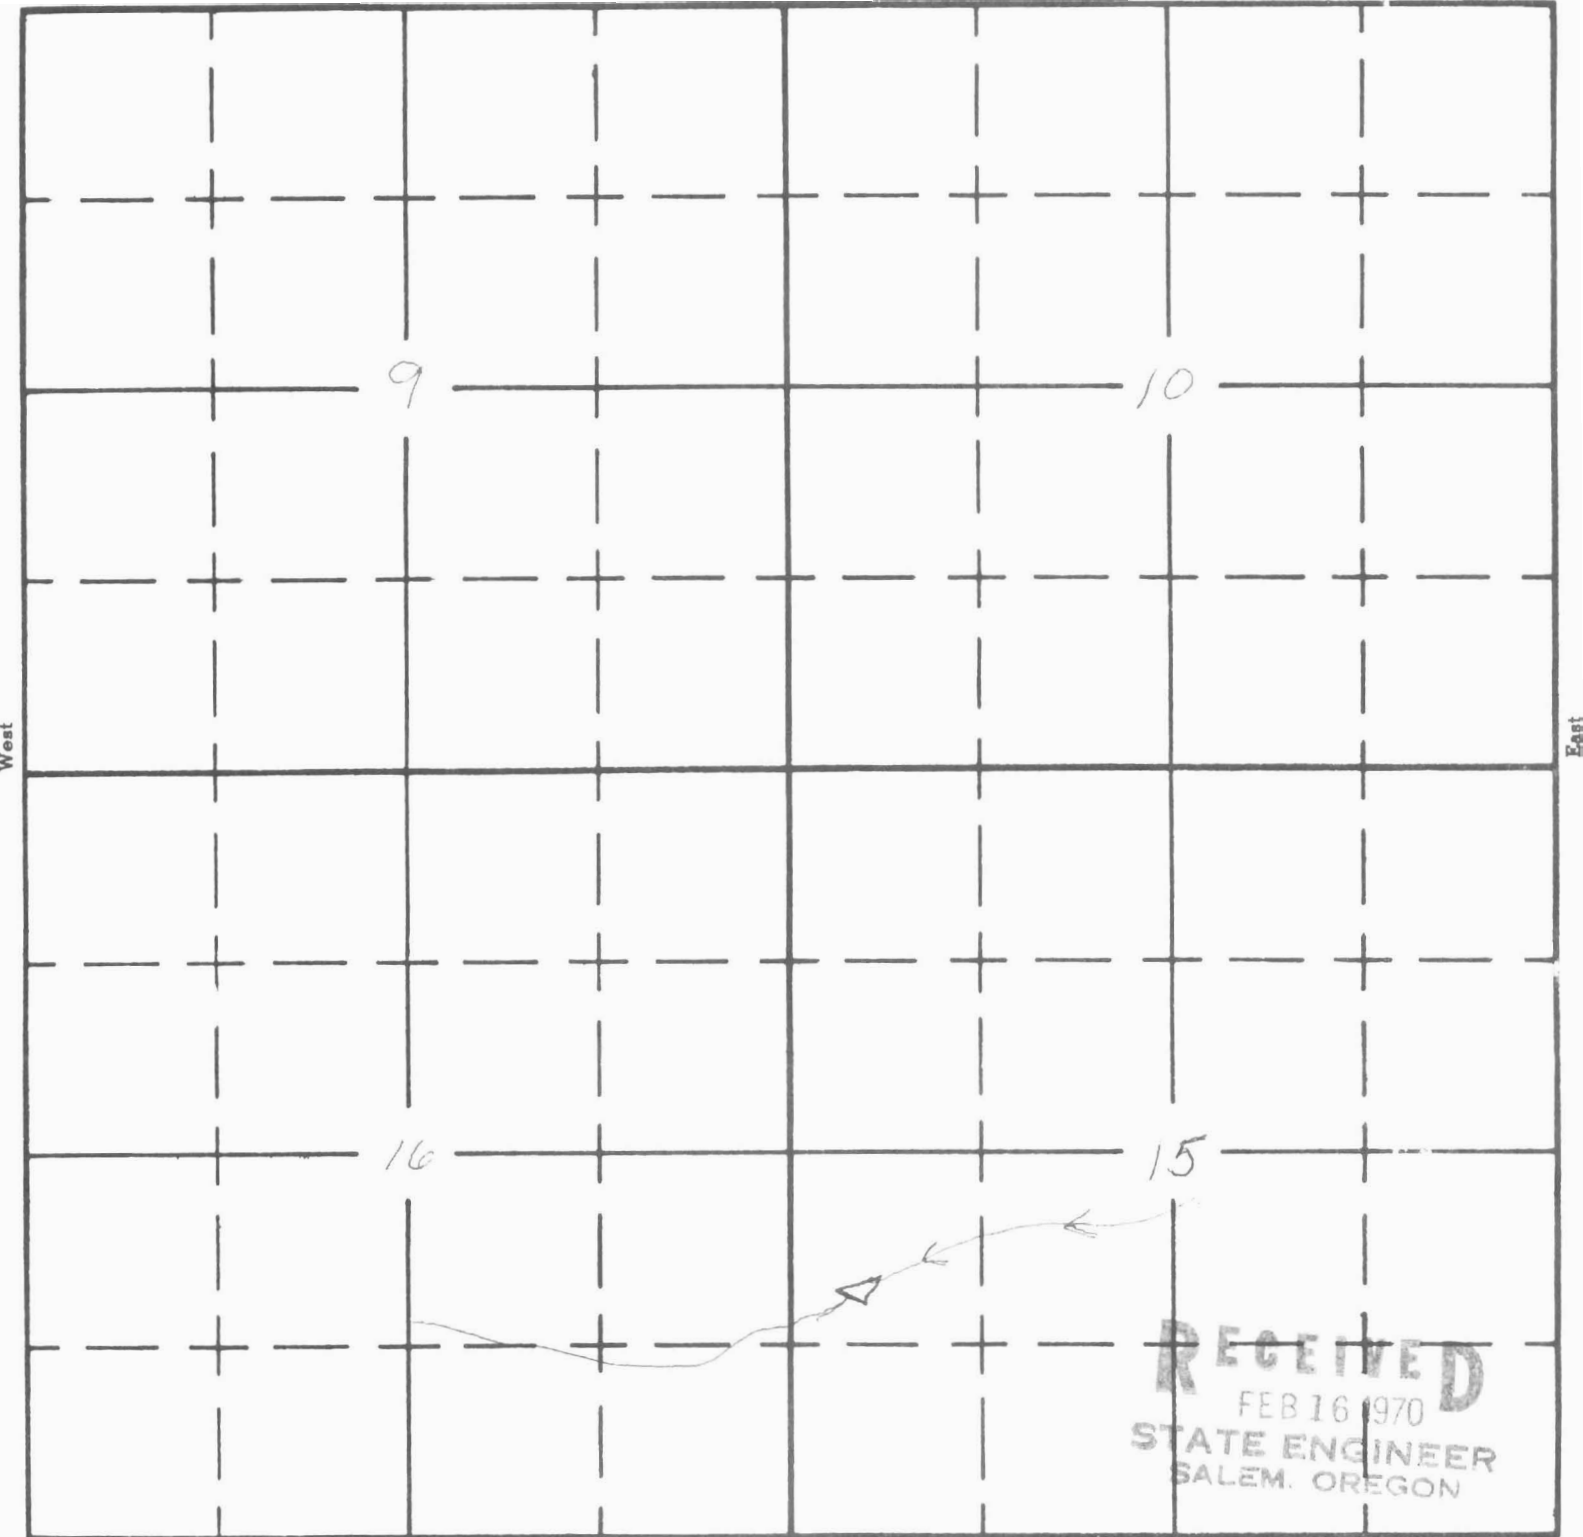

South

APPLICATION No. 7437
PERMIT No. 7437