

Form AI-187
March 1961

UNITED STATES
DEPARTMENT OF THE INTERIOR
BUREAU OF LAND MANAGEMENT

SECTION

SE SW

Oregon State Water Filings


Sec 19

TOWNSHIP 21^S, RANGE 43^E, W. M.

R 42^E

North

R 43^E

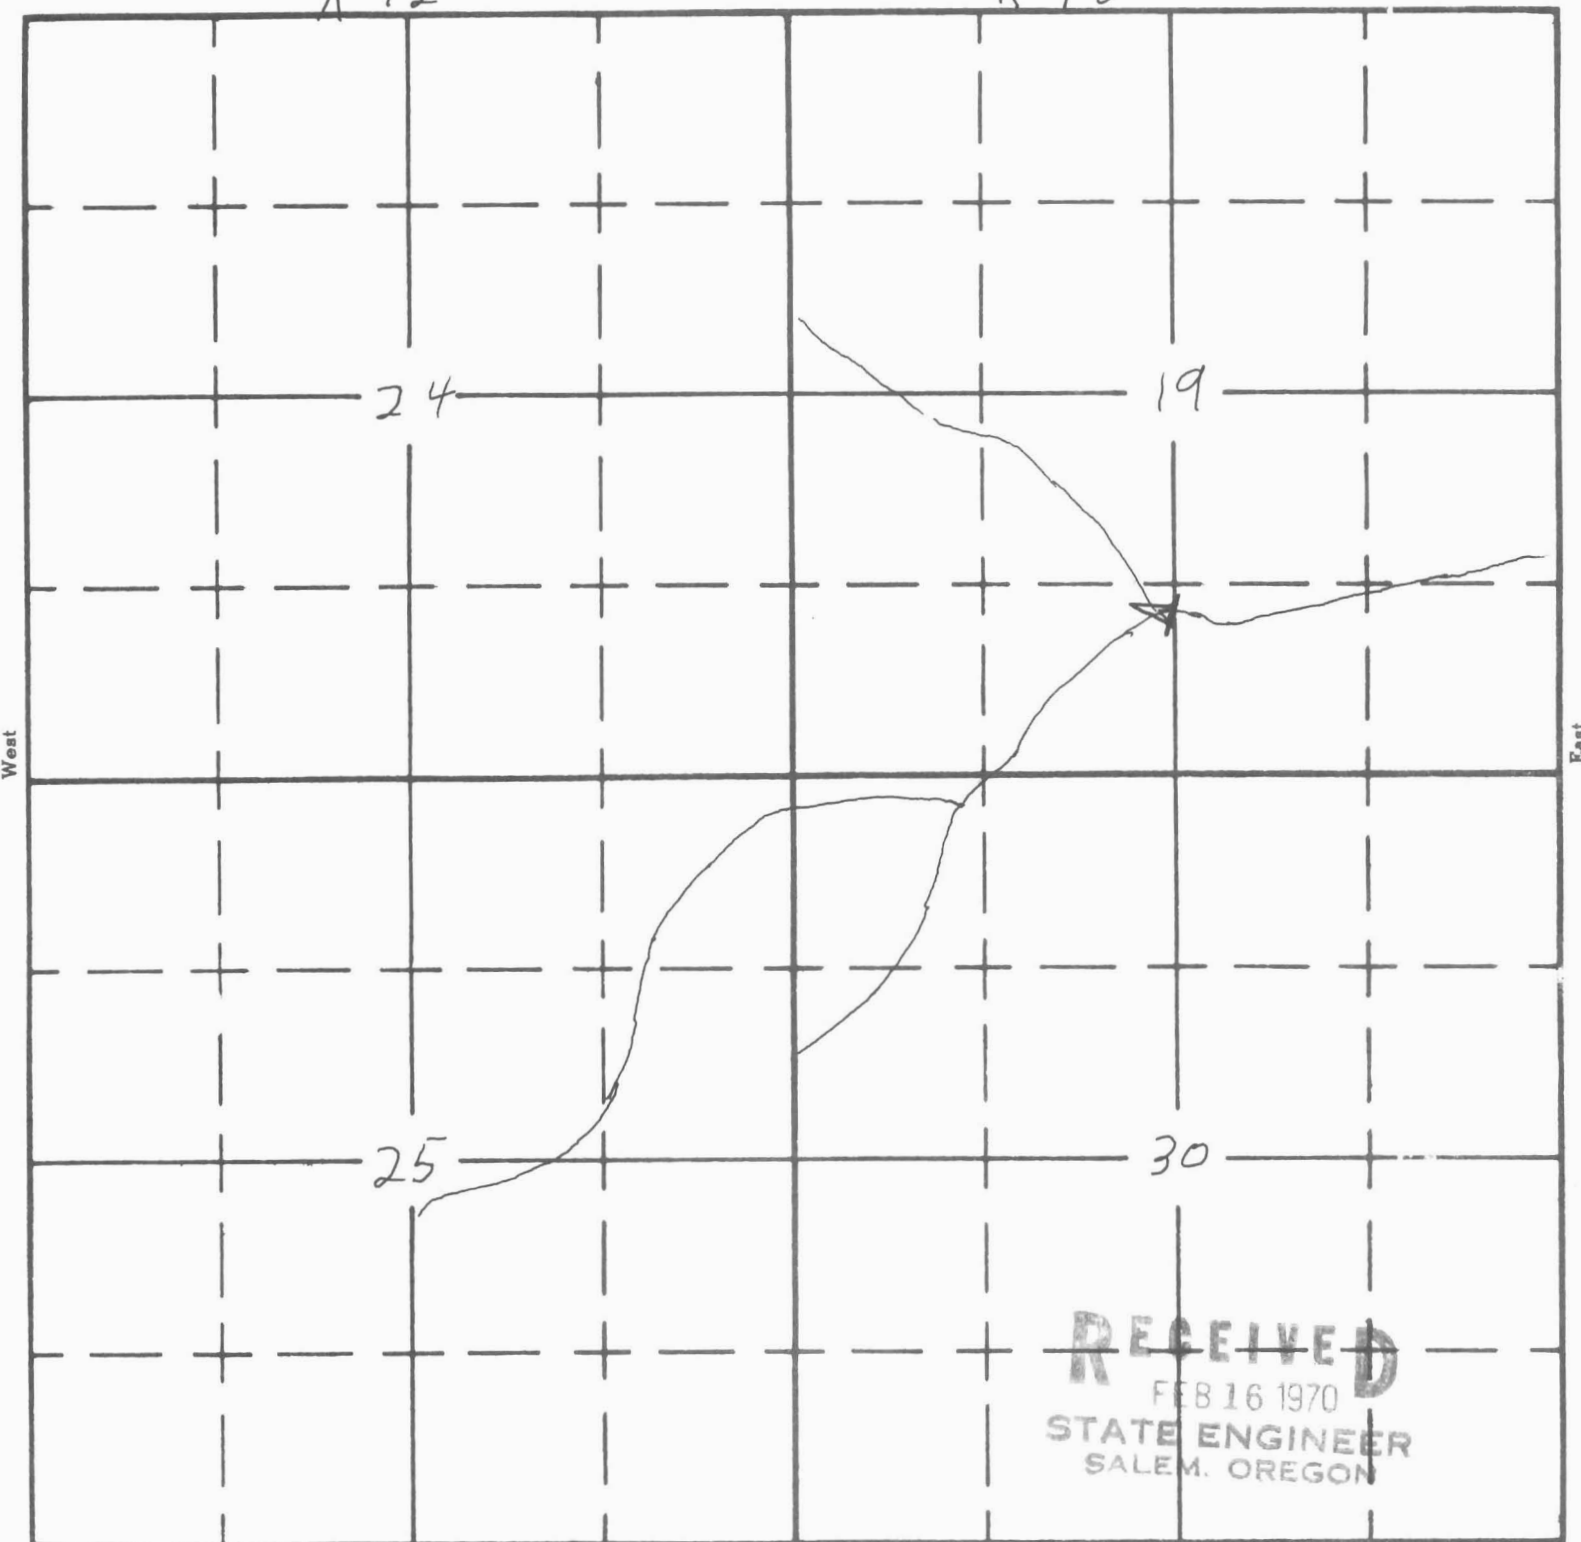

RECEIVED
FEB 16 1970
STATE ENGINEER
SALEM, OREGON

Conway Res.

South

