


UNITED STATES
DEPARTMENT OF THE INTERIOR
BUREAU OF LAND MANAGEMENT

SECTION NW⁴NE⁴
SEC 21

Oregon State Water Filings

TOWNSHIP 24S, RANGE 41E, W. M.

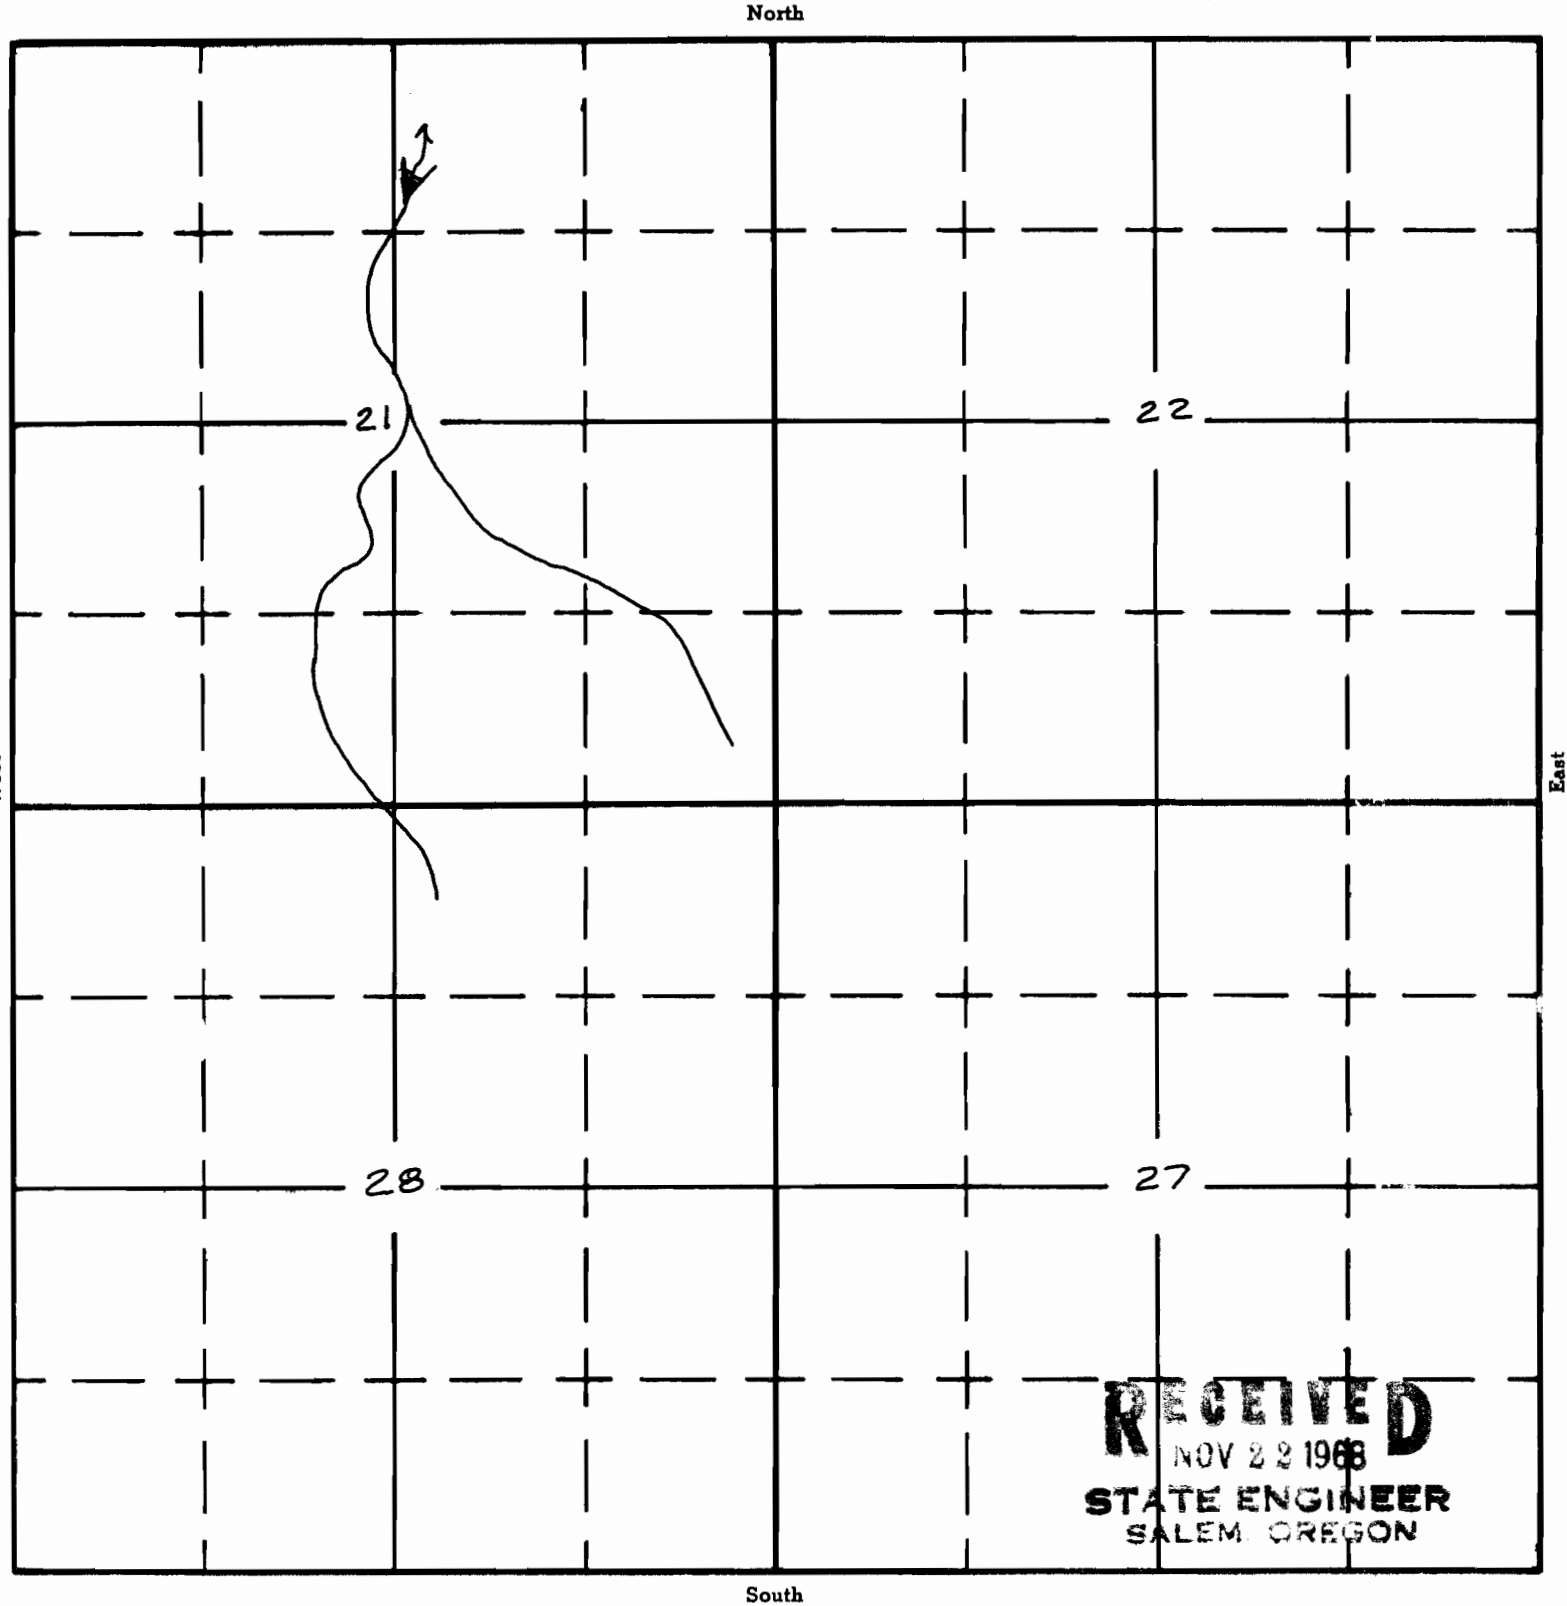

Robinson Res.

APPLICATION No. R-45572
PERMIT No. R 7451