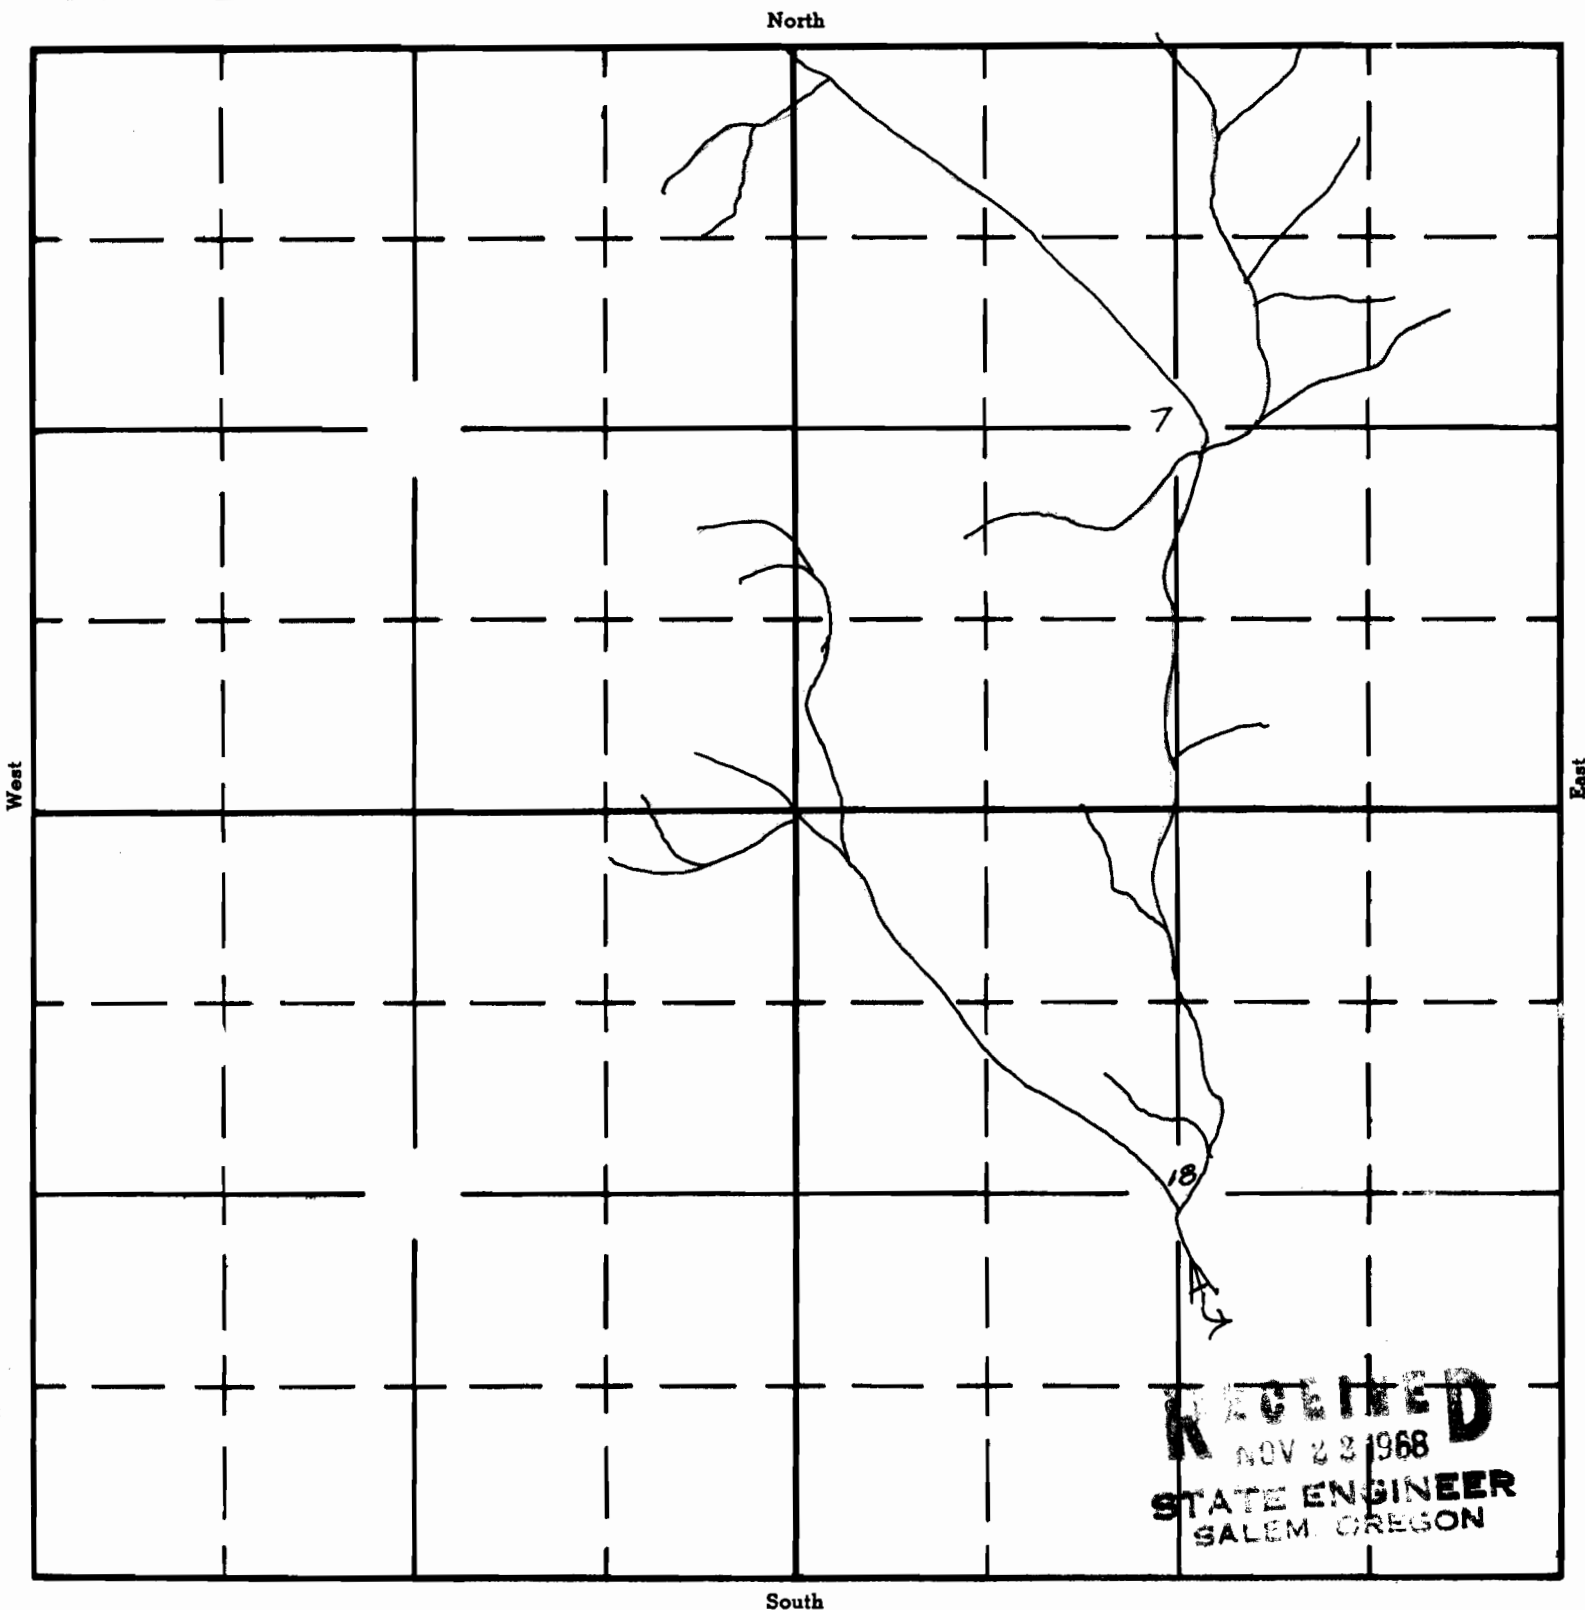


Oregon State Water Filings

TOWNSHIP 32S, RANGE 38E, W. M.

Hub Res.

APPLICATION No. *R-45580*
PERMIT No. *B 7459*