

UNITED STATES
DEPARTMENT OF THE INTERIOR
BUREAU OF LAND MANAGEMENT

SECTION


Oregon State Water Filings

NE 5 W 4
SEC 26

TOWNSHIP 39 S, RANGE 46 E, W. M.



North

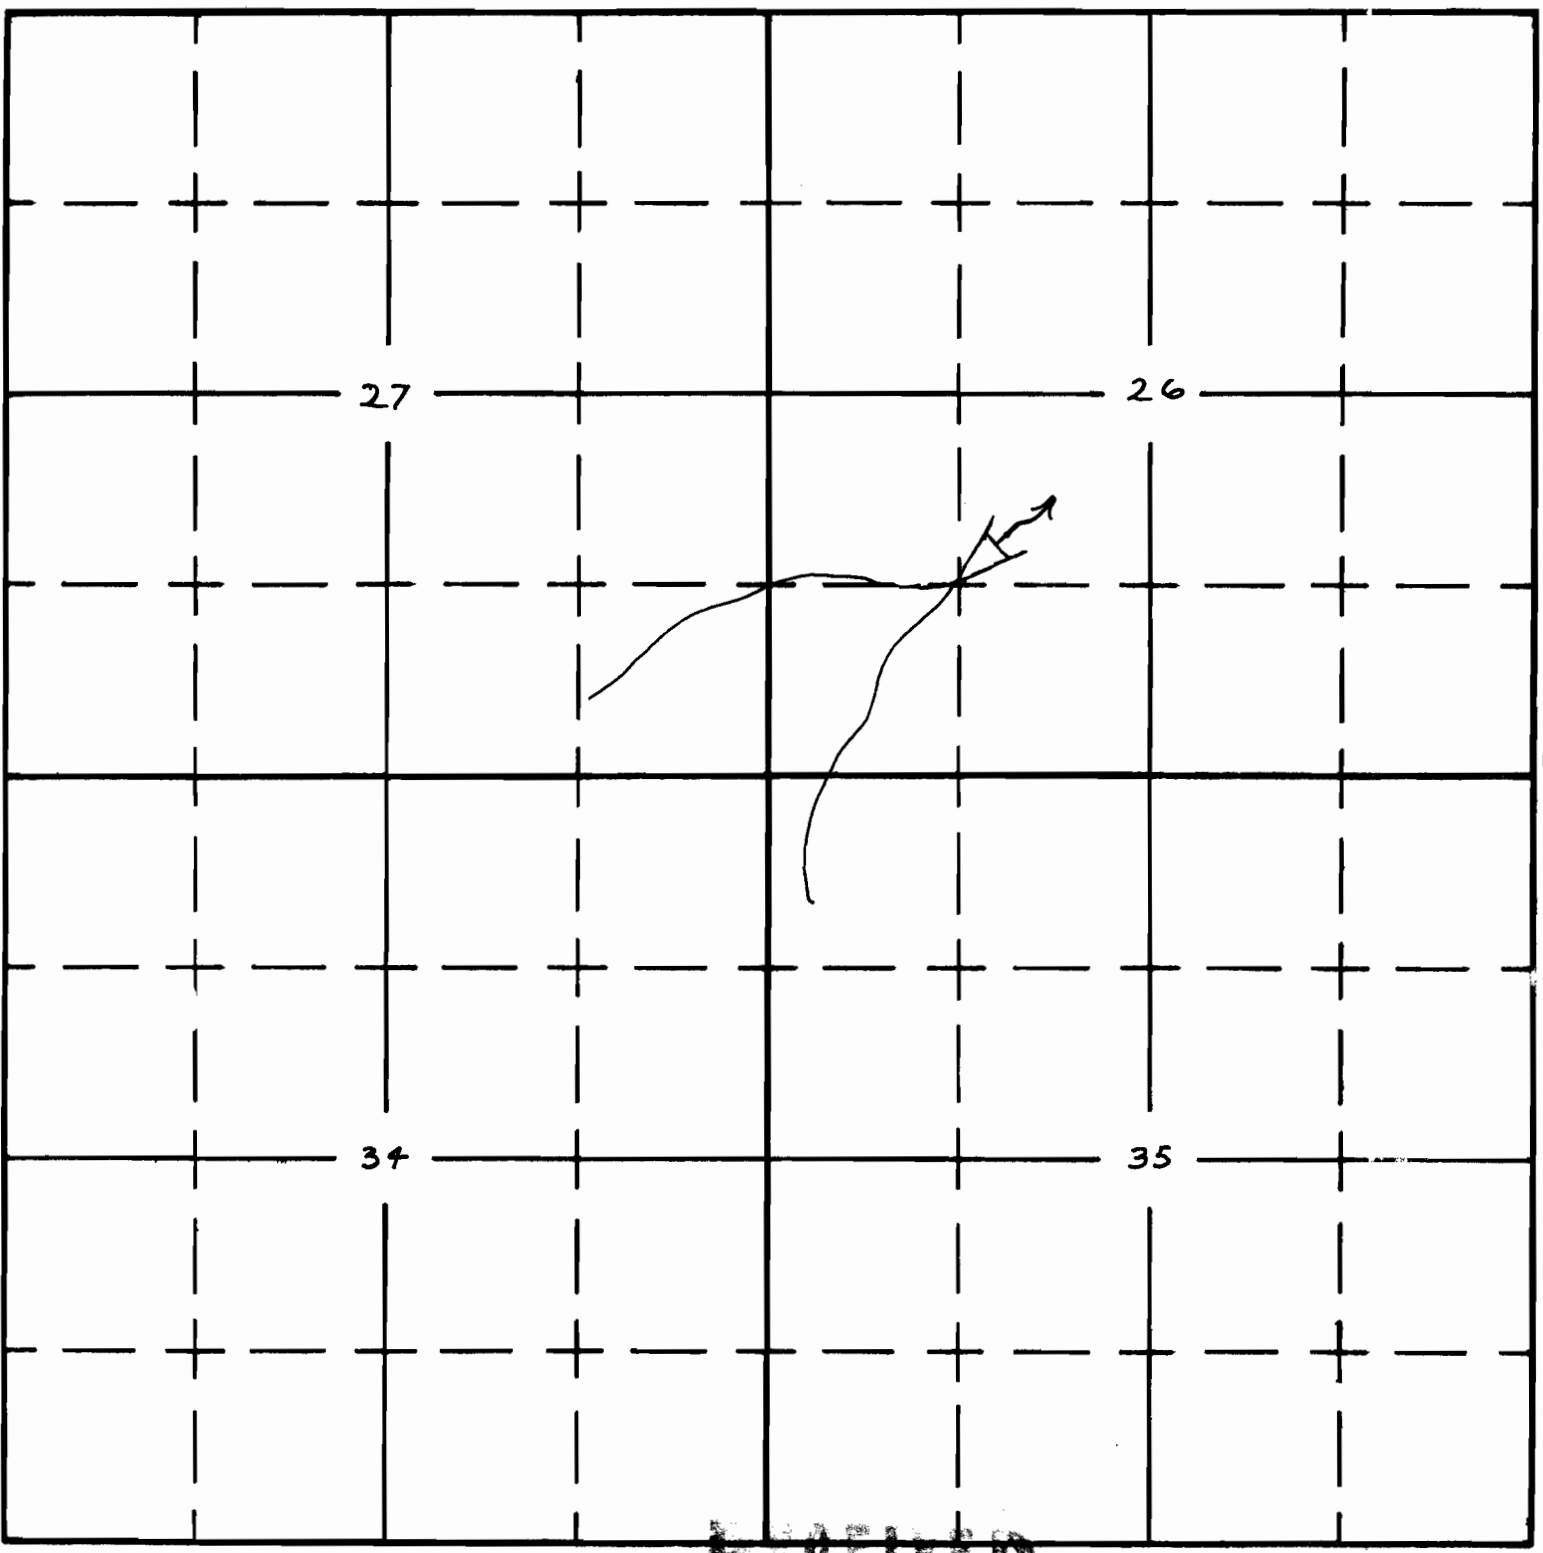

West

East

RECEIVED
NOV 22 1968

STATE ENGINEER
SANDY JOHNSON

APPLICATION No. R-45582
PERMIT No. 7461

Little Dry Res.