


UNITED STATES
DEPARTMENT OF THE INTERIOR
BUREAU OF LAND MANAGEMENT

SECTION
34th SE⁴
SEC. 29

Oregon State Water Filings
TOWNSHIP 36 S, RANGE 47 E, W. M.

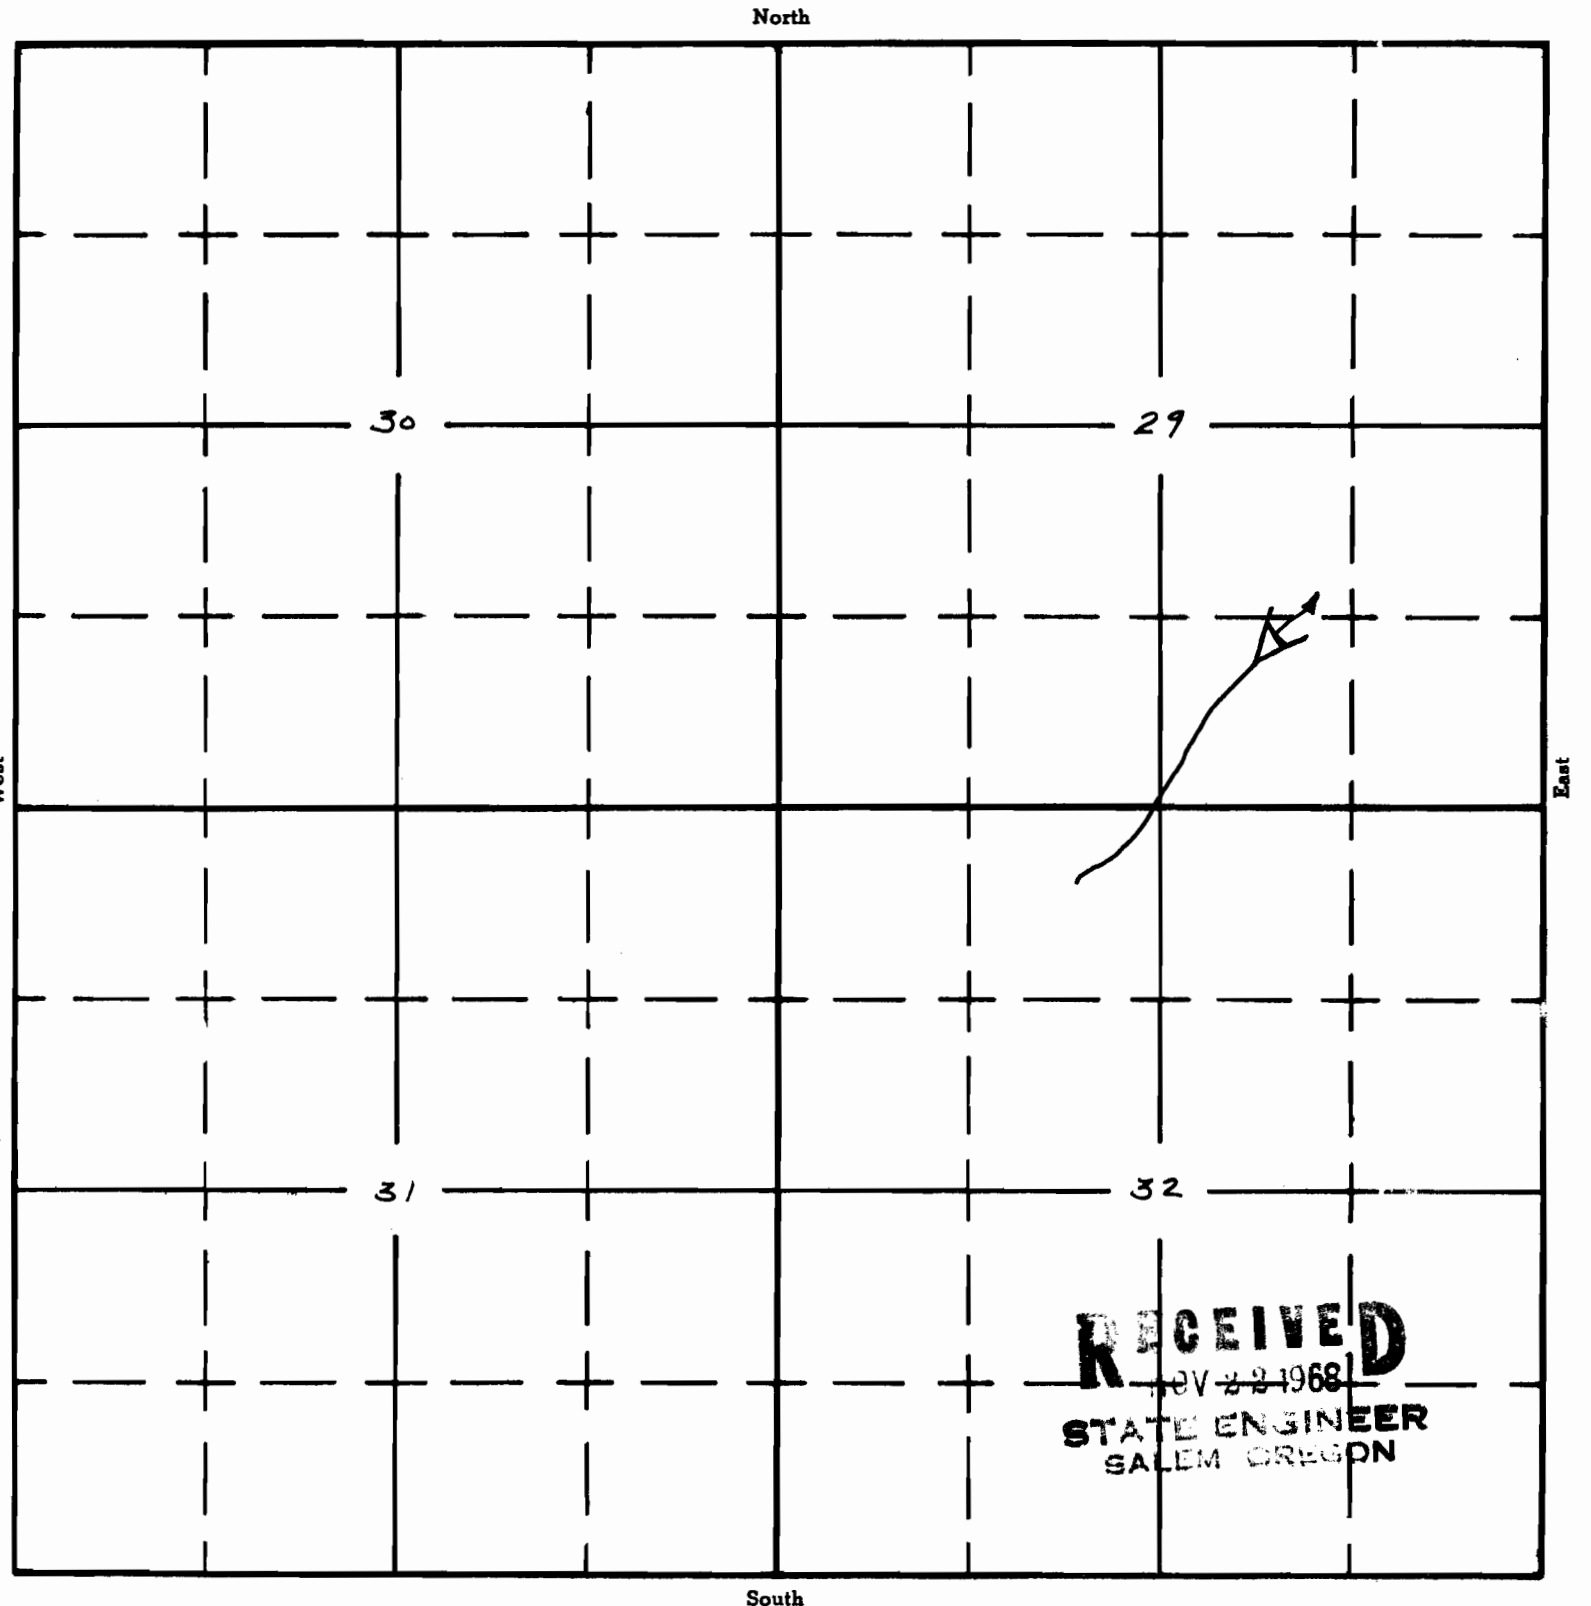

RECEIVED
STATE ENGINEER
SALEM OREGON

SOUTH DRUMMOND BASIN RES

APPLICATION No. *R-45584*
PERMIT No. **7463**