


UNITED STATES
DEPARTMENT OF THE INTERIOR
BUREAU OF LAND MANAGEMENT

SECTION
NE⁴ SE⁴
Sec 17

Oregon State Water Filings
TOWNSHIP 32S, RANGE 47, W. M.

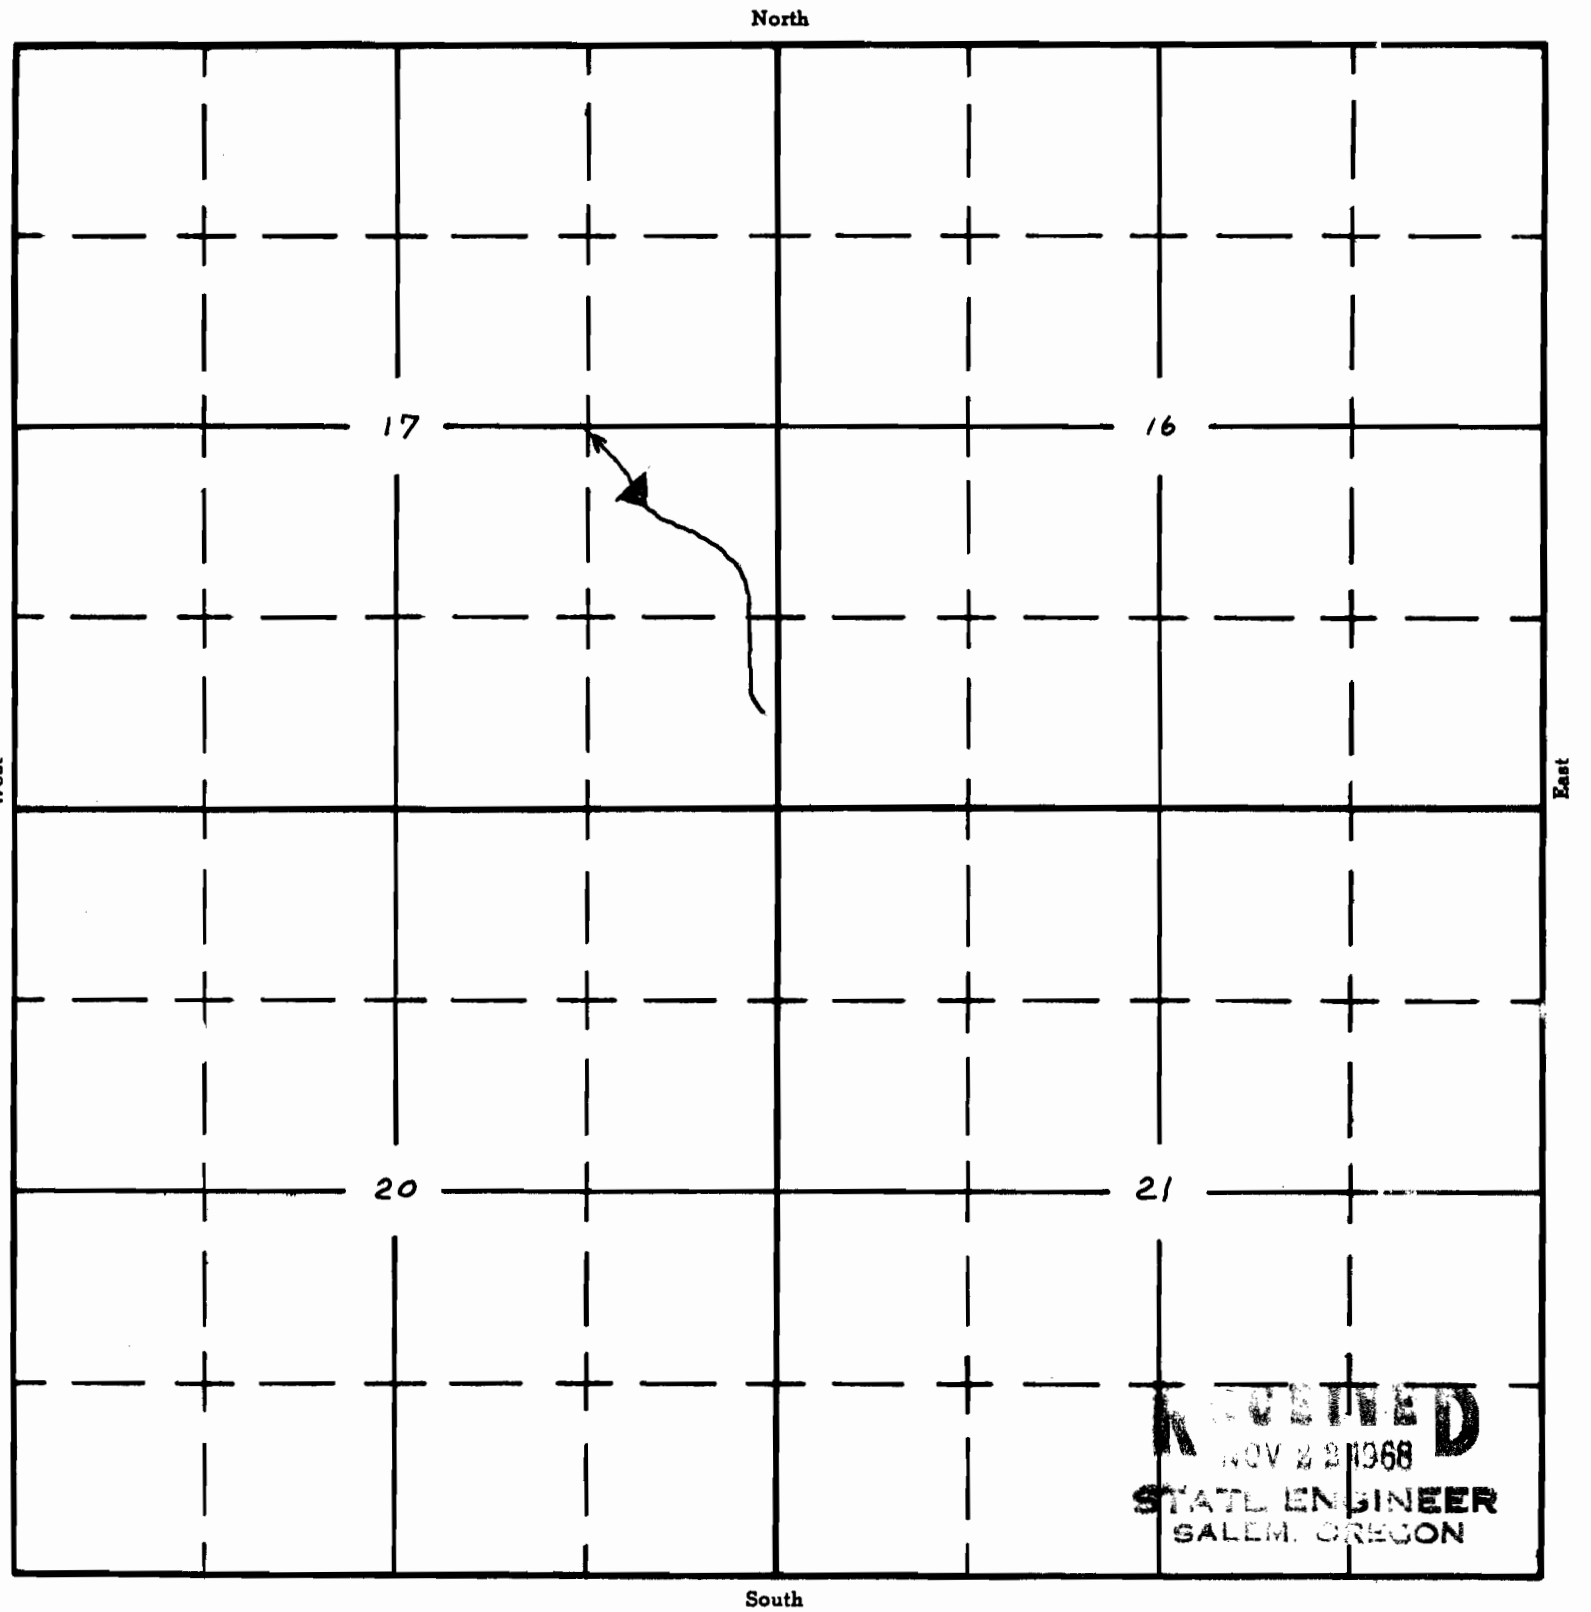

RECEIVED
NOV 22 1968
STATE ENGINEER
SALEM, OREGON

WEST PASTURE RES.

APPLICATION No. R 45589
PERMIT No. R 7468