


T.3S., R.4E., W.M.

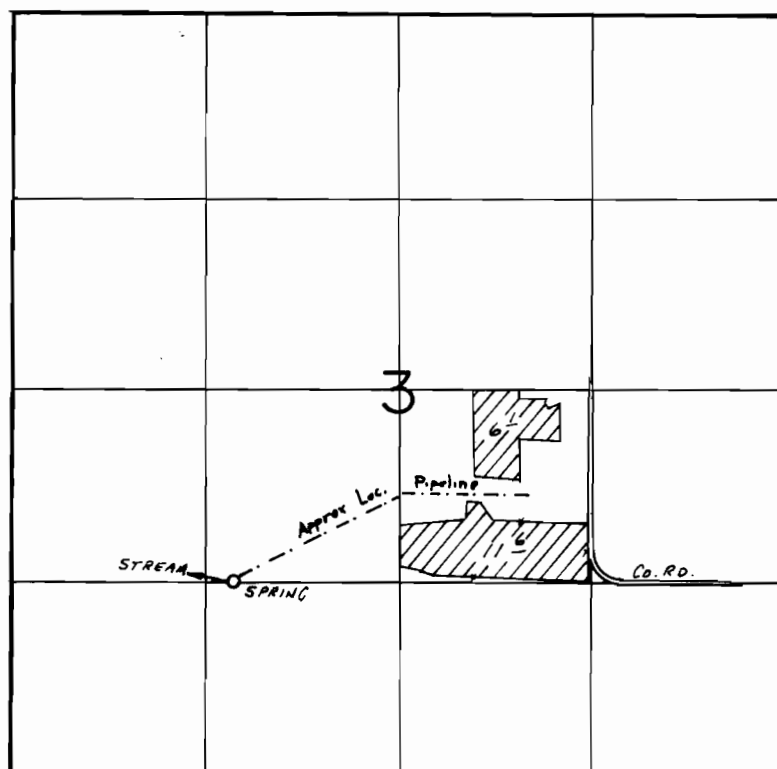

Div. Pt. Loc.: 10' N. & 180' E. FROM SW COR. NE 1/4 SW 1/4, SECTION 3.

SCALE: 1" = 1320'

FINAL PROOF SURVEY UNDER

Application No. 52056. Permit No. 39231.....
IN NAME OF

..... A. O. OLSEN

Surveyed Aug. 7.... 1984, by B.W. BISHOP.....