


T. 30S., R. 12W., W.M.

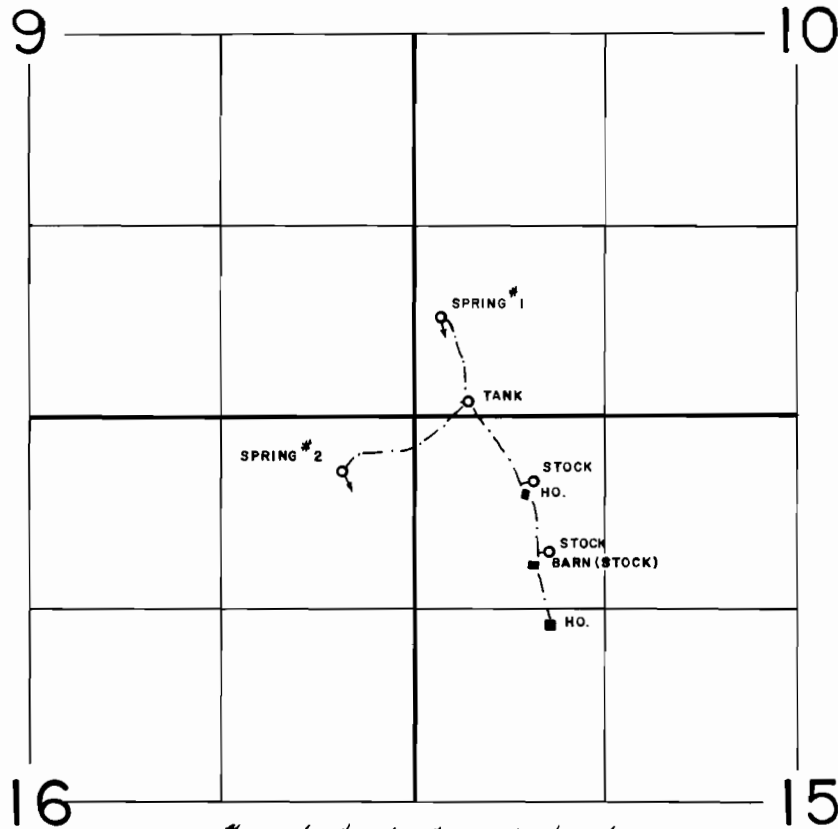

SPRINGS LOC.: #1- 690' N. of 180° E.; #2- 330' S. of 470' W., BOTH FROM THE NW COR. SEC. 15.

FINAL PROOF SURVEY UNDER

Application No. 57766.. Permit No. 43501.....
IN NAME OF

ALVIN C. YONALLY

Surveyed JULY 23, 1980, by J.S. DONALDSON