


T.13S. R.16E. W.M.

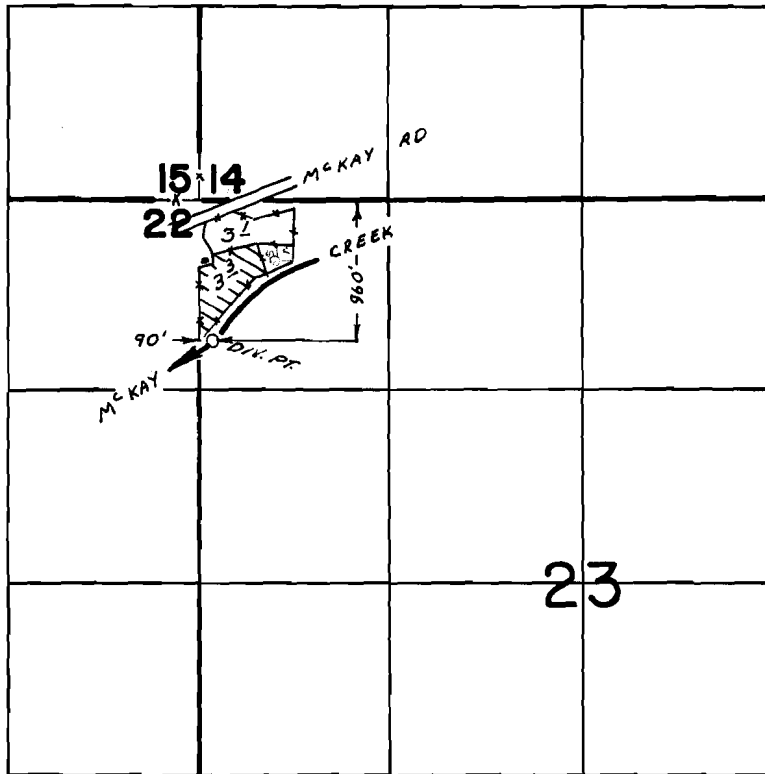

Cert. # 54379
(1978)

FINAL PROOF SURVEY
UNDER

Application No. 57287.. Permit No. 43142.....

IN NAME OF

..AARON D. & BERNIECE HARGIS.....

Surveyed FEB...29. 1980., by L.H. NUNN.....