


T. 24S., R. 5W., W.M.

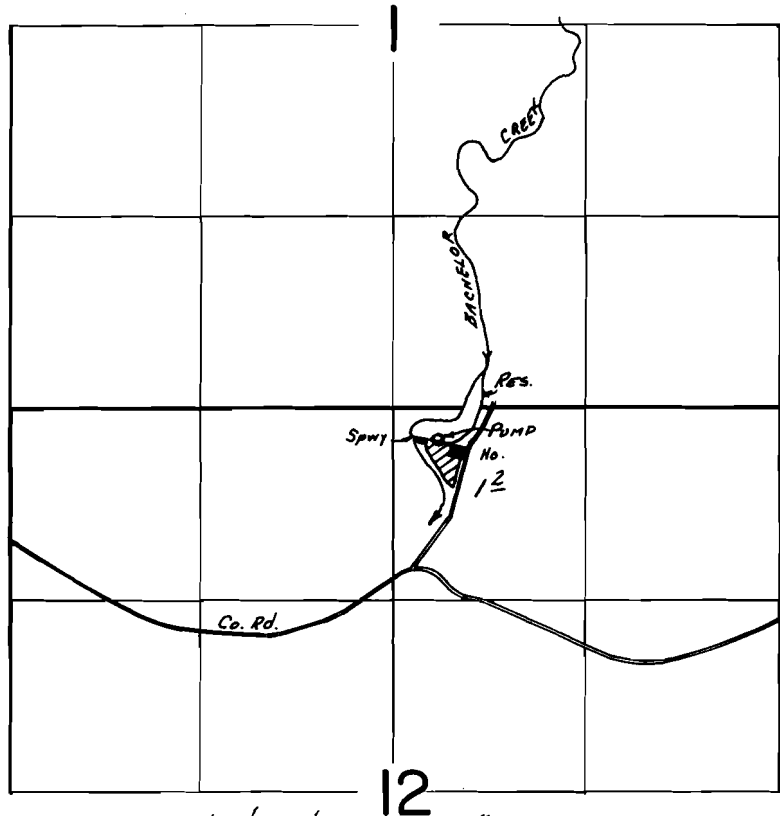

DAM LOC.: 200'S. & 200'E. FROM N¹/₄ COR. SEC. 12.

FINAL PROOF SURVEY
UNDER

R-53334 R-6403
Application No. 53335... Permit No. 40108.....
IN NAME OF

.....WILLIAM J. BARTON.....

Surveyed MAY 21, 1980, by J.S. DONALDSON

Doug. Co. 2455WNE

BWB