


T. 24S., R. 5W., W.M.

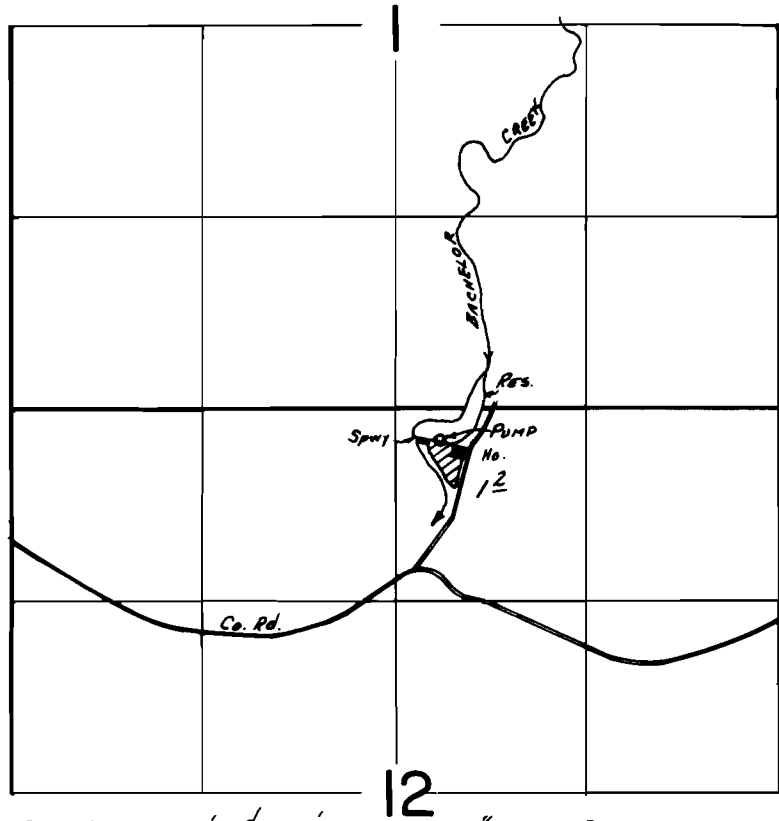

DAM LOC: 200'S. & 200'E. FROM N $\frac{1}{4}$ COR. SEC. 12.

FINAL PROOF SURVEY UNDER

R-53334 R-6403
Application No. ~~53335~~ Permit No. ~~40108~~.....
IN NAME OF

.....WILLIAM J. BARTON.....

Surveyed MAY 21, 1980, by J.S. DONALDSON