


T.30S. R.6W. W.M.

Sec. 33

SW 1/4 SW 1/4

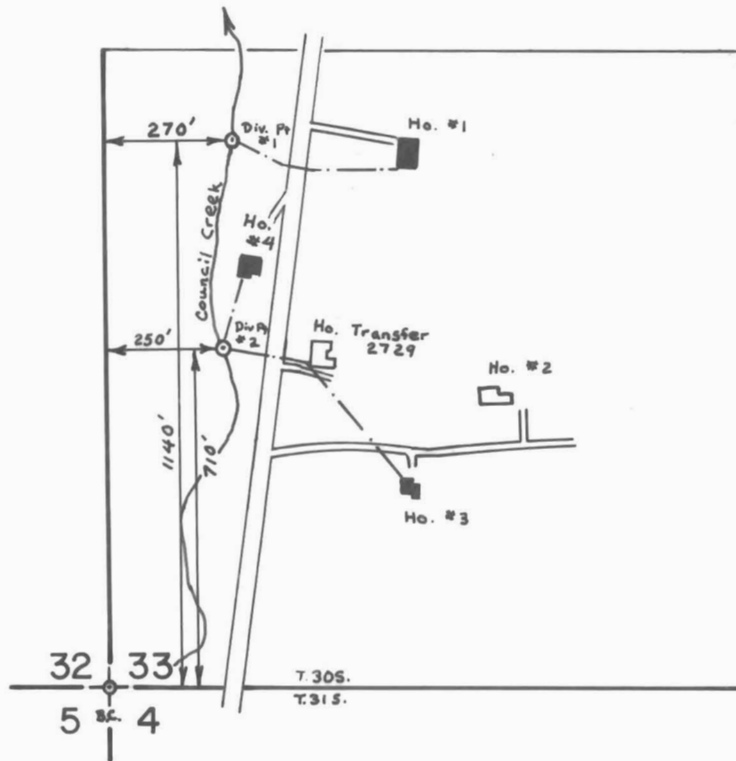

SCALE: 1" = 400'

**FINAL PROOF SURVEY**  
UNDE.

Application No. 49475 Permit No. 37060

IN NAME OF  
DOUGLAS, Jr. & VICKI D. SMALLEY  
Mrs. J. H. Klope

Surveyed Oct. 25, 1979, by S. Donaldson