


T.32 S. R.7 W. W.M.

36

NW 1/4 SE 1/4

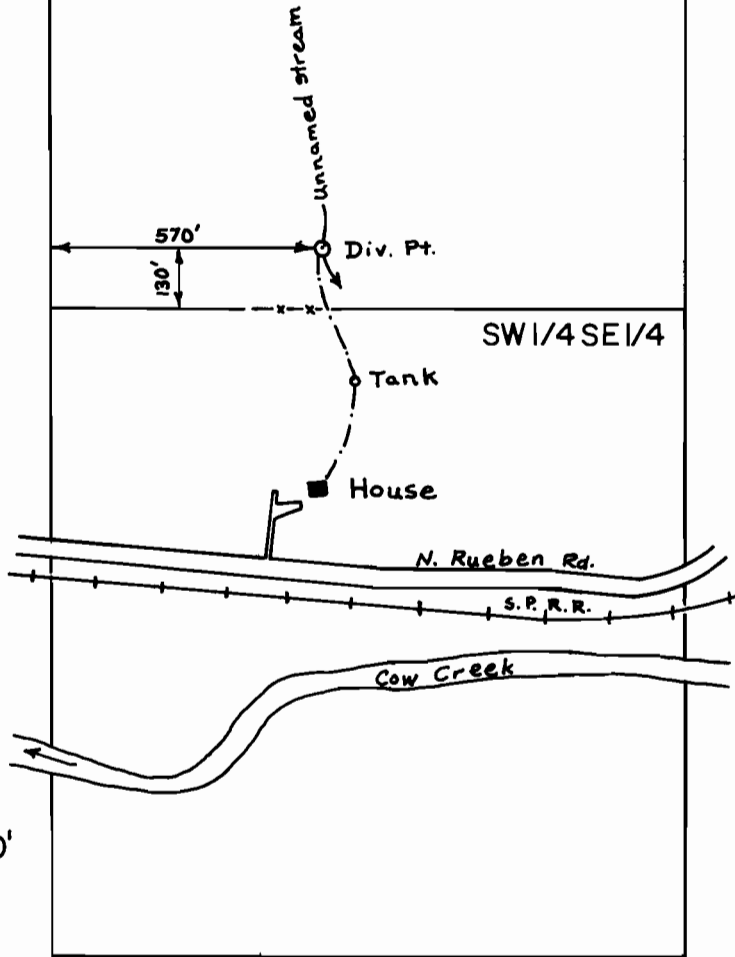

SCALE: 1" = 400'

FINAL PROOF SURVEY
UNDER

Application No. 50768 Permit No. 38339
IN NAME OF
JOHN SPARKS

Surveyed Oct. 17 1979, by S. Donaldson