


T.22S. R.7W. W.M.

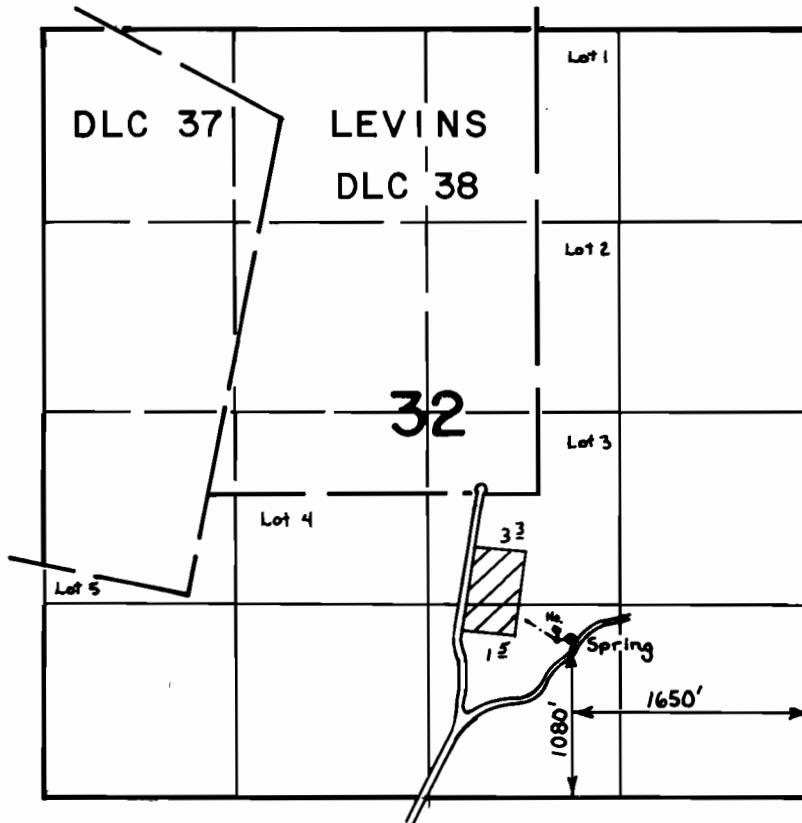

SCALE: 4" = 1 mile

**FINAL PROOF SURVEY**  
UNDER

Application No. 50787 Permit No. 38348  
IN NAME OF

KENNETH P. & MARY L. THOMASON

Surveyed Aug. 22, 1979. by S. Donaldson...