


T.27S.,R.5W.,W.M.

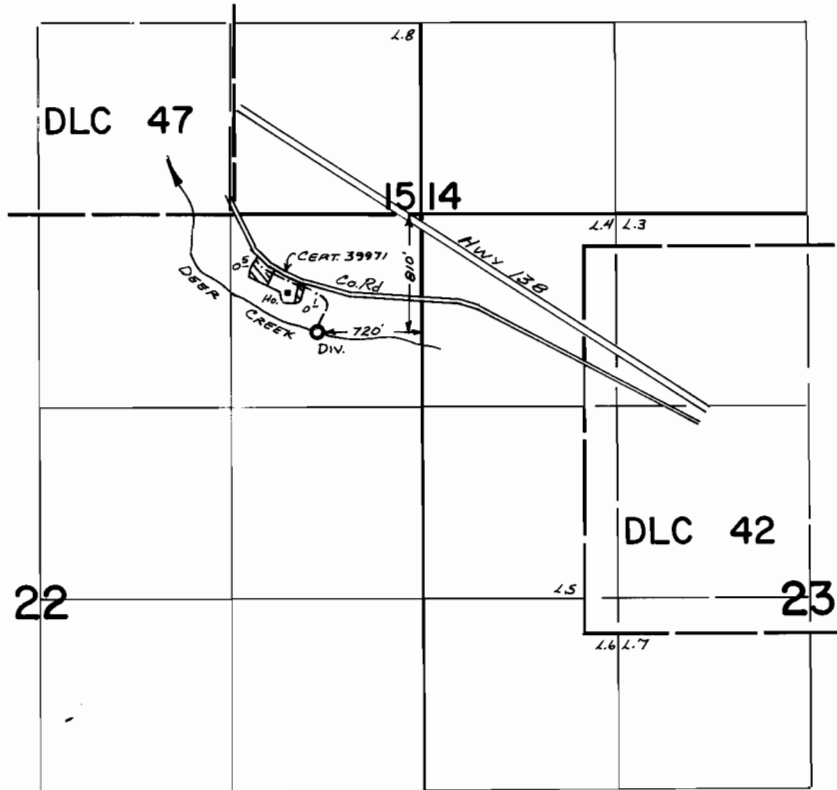

FINAL PROOF SURVEY
UNDER

Application No. 50969 Permit No. 38474
IN NAME OF

JAMES L. BAKER

Surveyed March 12, 1980, by J.S. DONALDSON.