


T. 26S., R. 3W., W.M.

SEC. 33

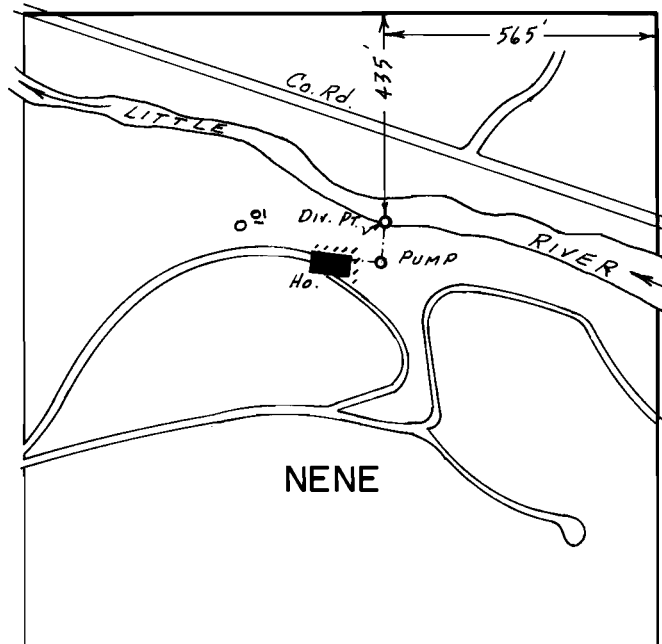

SCALE: 1" = 400'

**FINAL PROOF SURVEY**  
UNDER

Application No. 51725... Permit No. 38987.....  
IN NAME OF

EUGENE M. & LUCILLE M. VAN DRIMMELEN

Surveyed APR. 29, 1980, by J.S. DONALDSON