


T. 27S., R. 5W., W.M.

SEC. 24

SESW

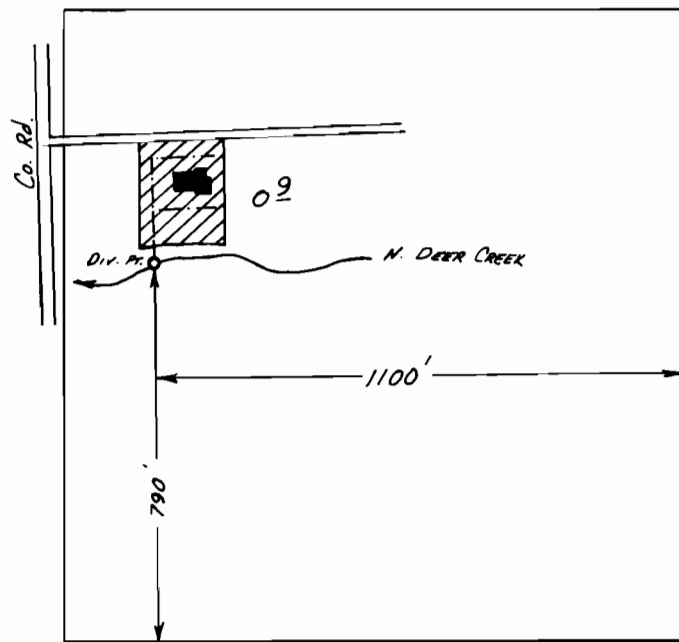

SCALE: 1" = 400'

**FINAL PROOF SURVEY**  
UNDER

Application No. 51954..... Permit No. 39080.....  
IN NAME OF

..... RICHARD DOUGLAS BAGLEY .....

Surveyed APR. 28. 1980., by J.S. DONALDSON