


T.21&22S.,R.5W.,W.M.

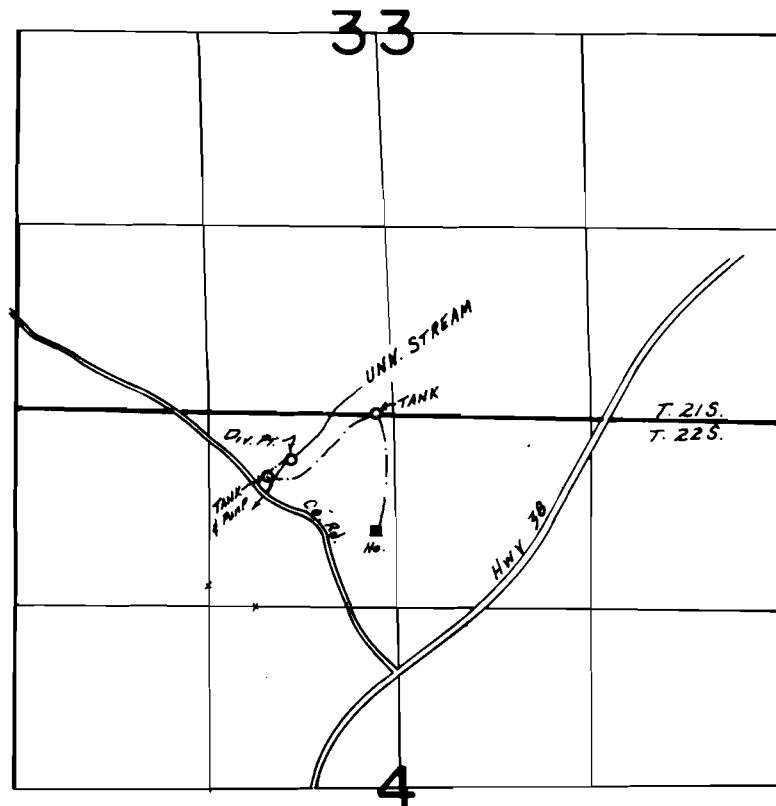

Div. Pt. Loc.: 310'S. & 710'W. FROM N. 1/4 Cor. Sec. 4.

FINAL PROOF SURVEY
UNDER

Application No. 52245... Permit No. 39320...
IN NAME OF

.....ROSS WILLIAMS.....

Surveyed APR. 30. 19.80. by J.S. DONALDSON