


T.25S. R.6W. W.M.

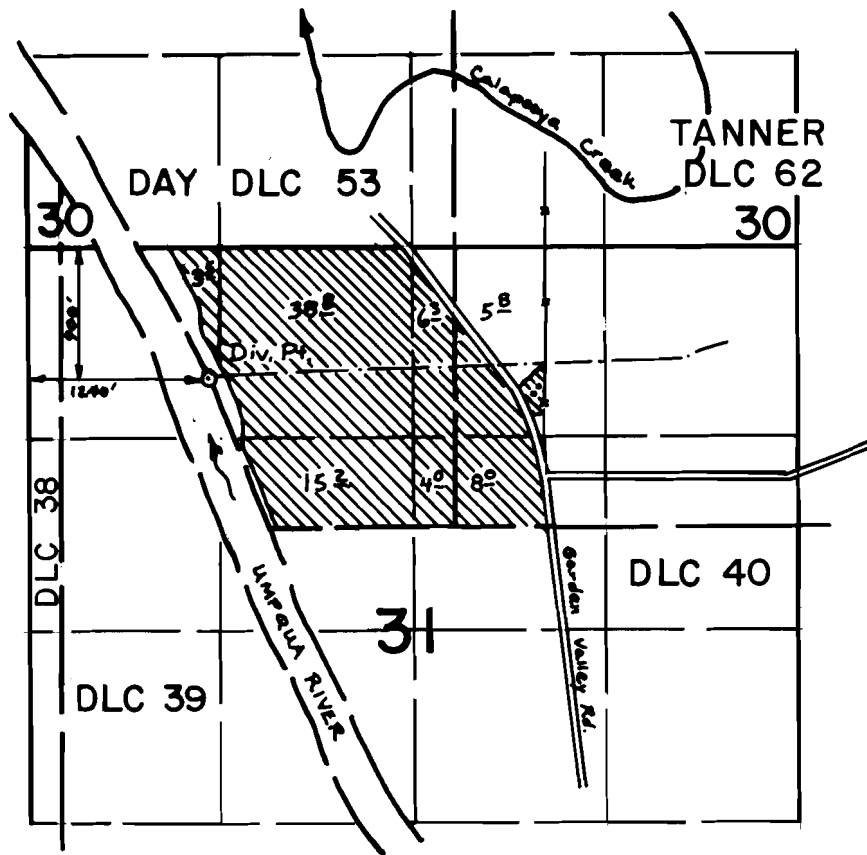

SCALE: 4" = 1 mile

**FINAL PROOF SURVEY**  
UNDER

Application No. 52273... Permit No. 39337...  
IN NAME OF

TED A. ROADMAN & PAUL NORRIS

Surveyed July 17, 1979, by S. Donaldson...

*alt*