


T.26S., R.3W., W.M.  
SEC. 19

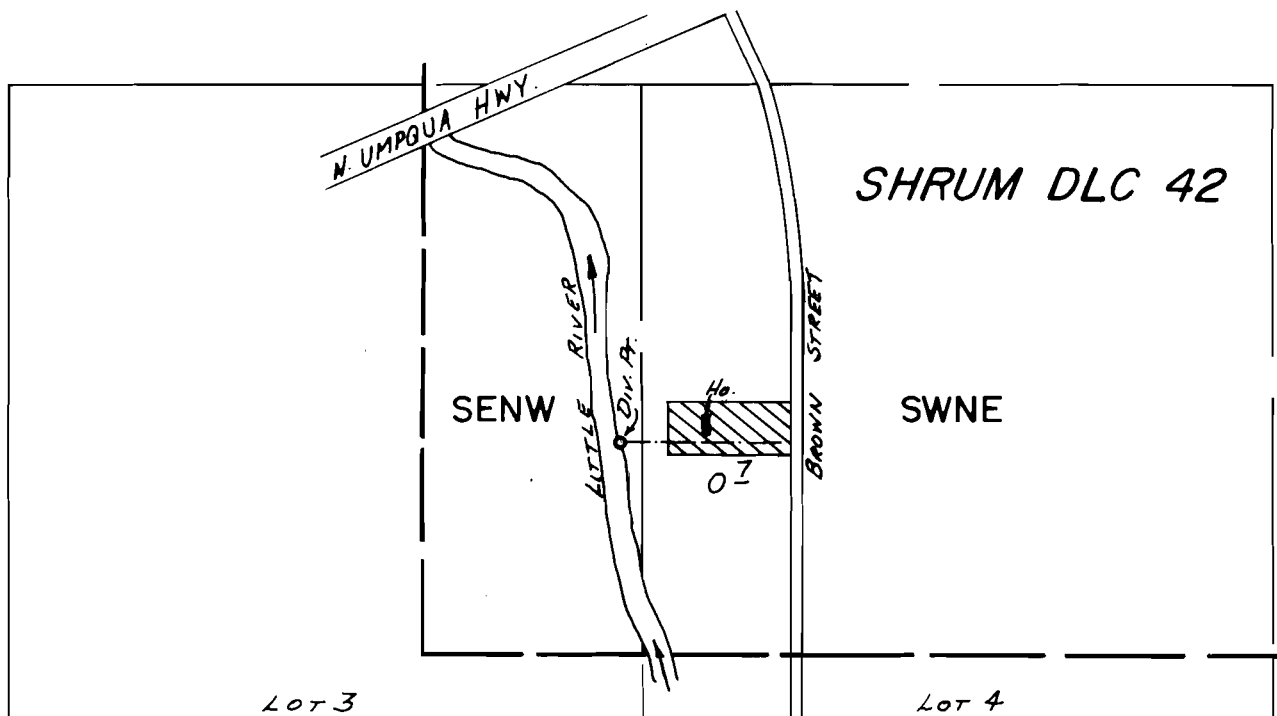

DIV. PT. LOC.: 440' N. & 410' E. FROM SW COR. SHRUM DLC 42

SCALE: 1" = 400'

**FINAL PROOF SURVEY**  
UNDER

Application No. 53492... Permit No. 39793.....  
IN NAME OF

.....EVELYN B. PACKARD.....

Surveyed APR. 17... 19.80., by J.S. DONALDSON