


T.26S. R.5W. W.M.

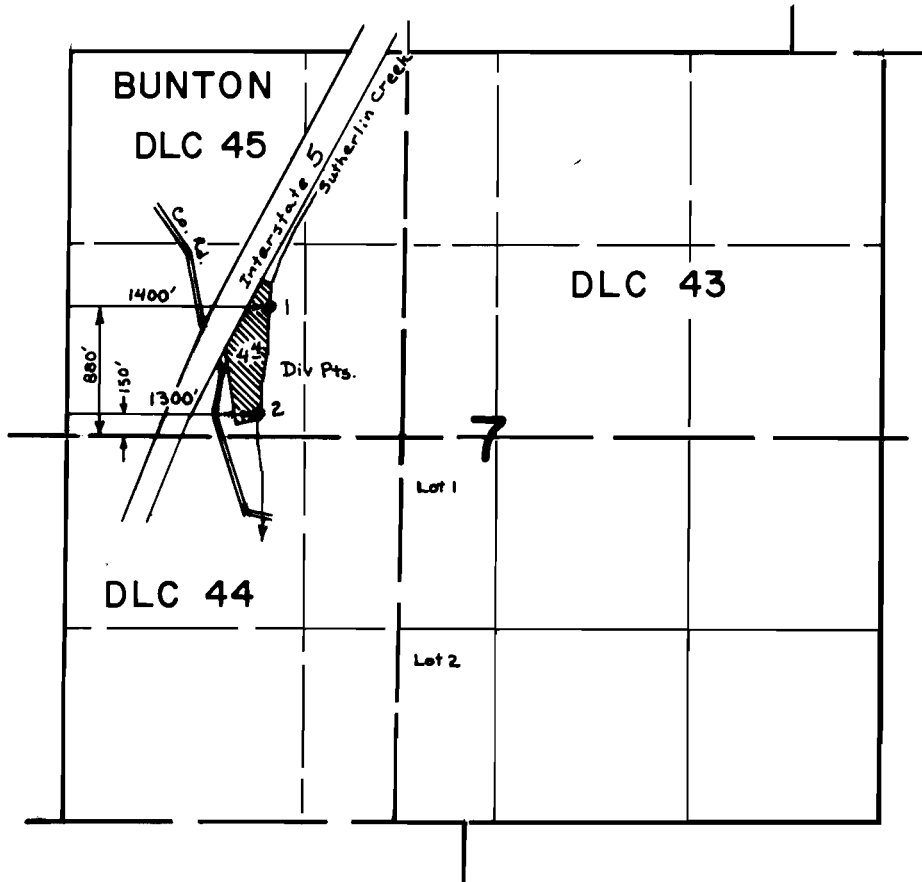

SCALE: 4" = 1 mile

**FINAL PROOF SURVEY**  
UNDER

Application No. 54594. Permit No. 40963...  
IN NAME OF

**LAURENCE N. & MARGARET E. ROBERTS**

Surveyed March 18, 1980, by S. Donaldson.....