


T. 24S., R. 4W., W.M.

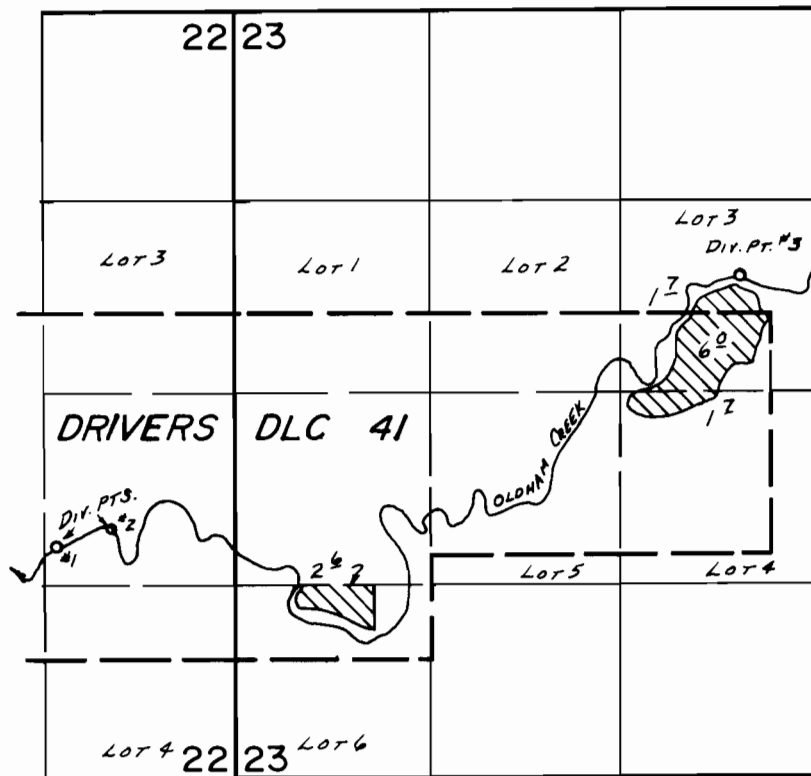

Div. PTS. Loc.: #1-1540'N. & 1260'W.; #2-1720'N. & 840'W.; #3-3440'N. & 3450'E, ALL FROM SW COR. SEC. 23.

FINAL PROOF SURVEY UNDER

Application No. 55131..... Permit No. 41336.....
IN NAME OF

.....C. B. & MEARLE C. WALLACE.....

Surveyed MAY 27..... 1980, by J. S. DONALDSON