


T. 26S., R. 5W., W.M.

SEC. 23

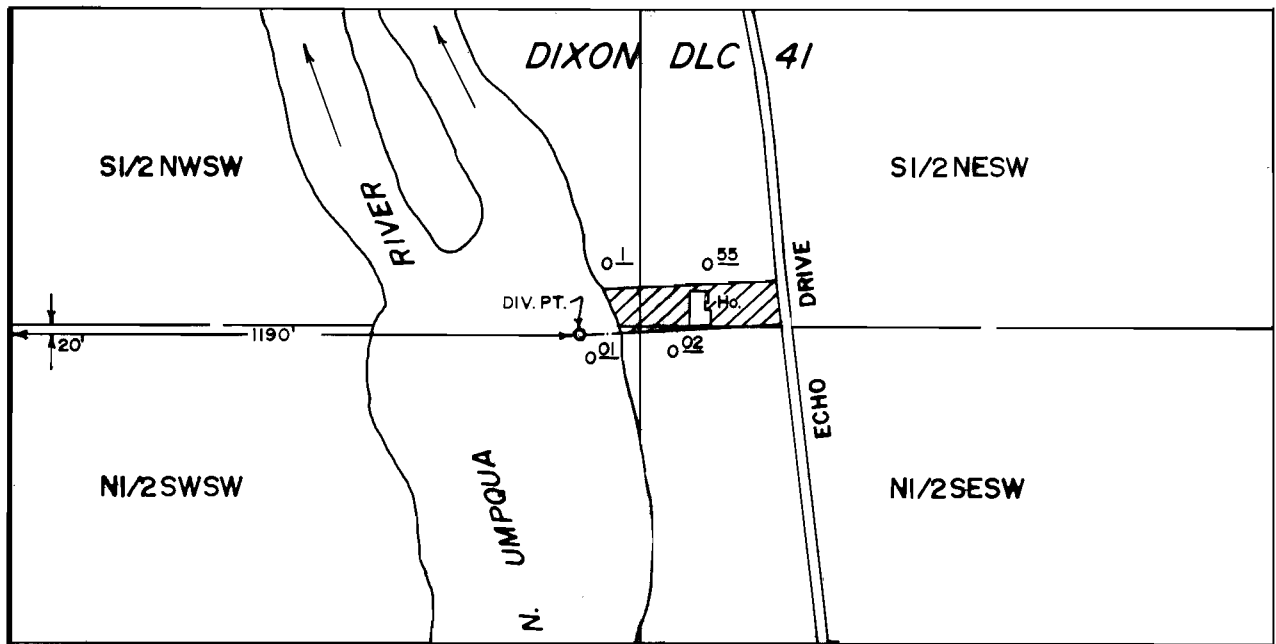

SCALE: 1" = 400'

**FINAL PROOF SURVEY**  
UNDER

Application No. 55958... Permit No. 41932.....  
IN NAME OF

.....WILLIAM L. HUTCHERSON.....

Surveyed MAY 1..... 1979., by J.S. RONALDSON.....

*RWB*